
















15 14
23 24

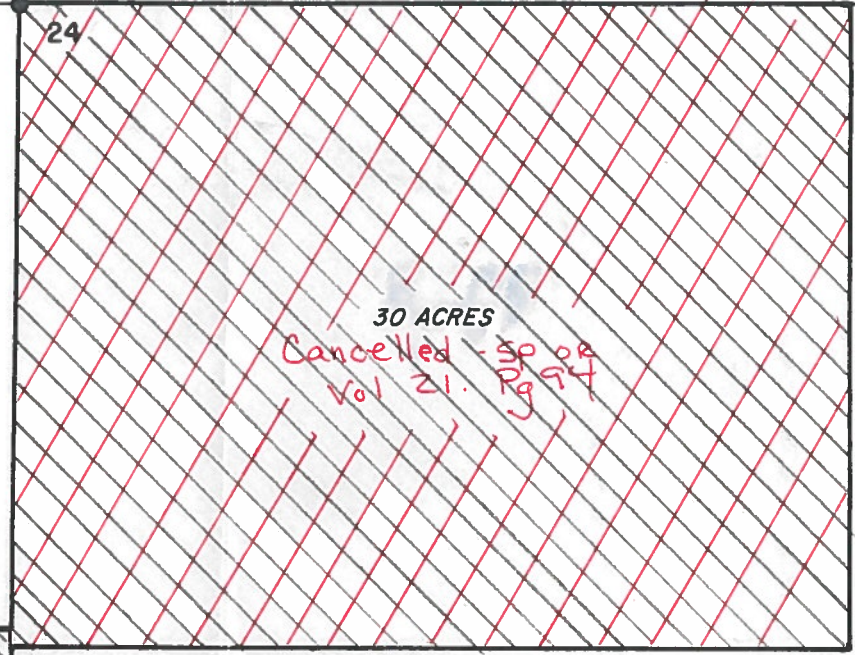

NW 1/4 OF NW 1/4

This map prepared by the department
to represent the remaining portion of
cert 3222 that was not canceled
by SP or Vol 21 pg 94. JP
24-FEB-16

REGISTERED
OREGON
LAND SURVEYOR

Ralph G. Barnes

MAY 5, 1950
RALPH G. BARNES
263

RECEIVED
MAY 5 1950
STATE ENGINEER
SALMON, OREGON

Application No. G-2349
Permit No. G-2224