


T. 7 S. R. 4 W. W. M.

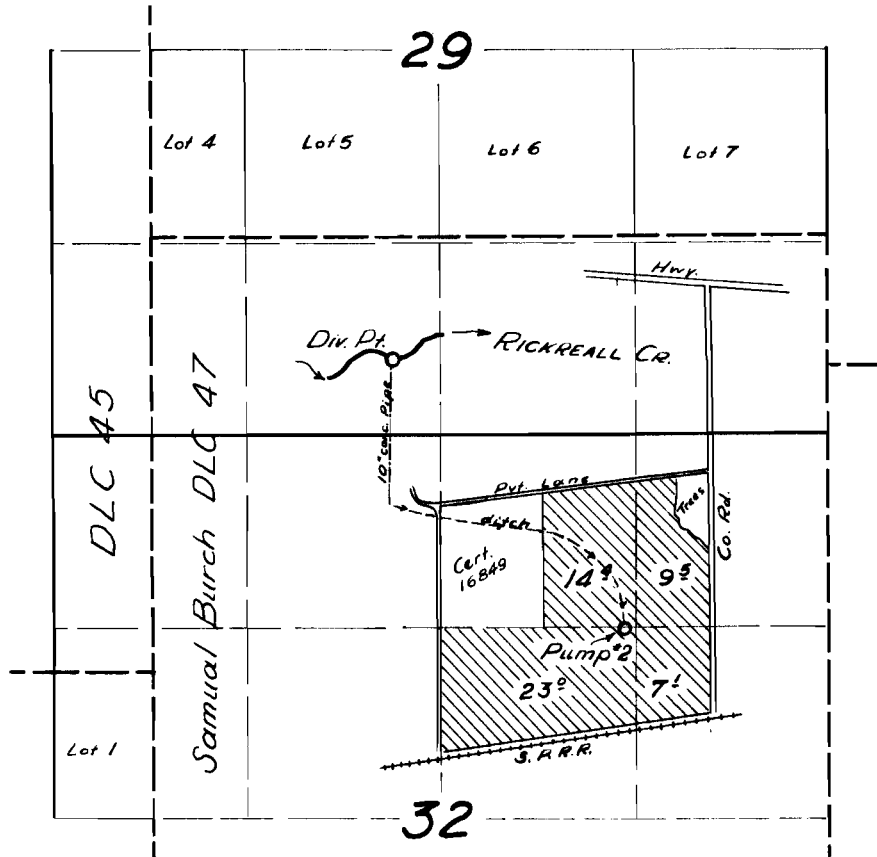

FINAL PROOF SURVEY

UNDER

Application No. 23134 Permit No. 16419

IN NAME OF

C. BARENDECHT

Surveyed 19 Mar. 1957, by *E. Pluhilby*