


T. 1 N. R. 3 W. W. M.

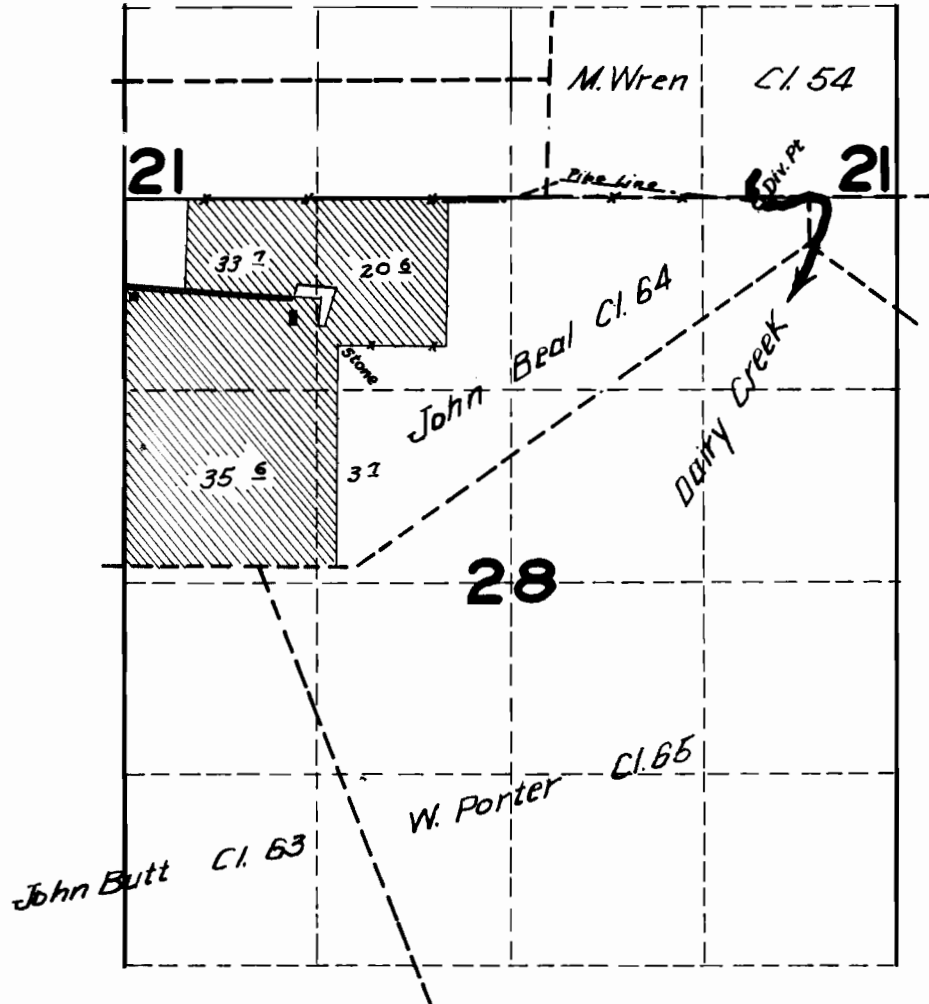

FINAL PROOF SURVEY

UNDER

Application No. 23117 Permit No. 10220

IN NAME OF

GEORGE HERMENS

Surveyed June 6, 1952, by H. J. COFFMAN