


T.4S.R.3W.W.M.

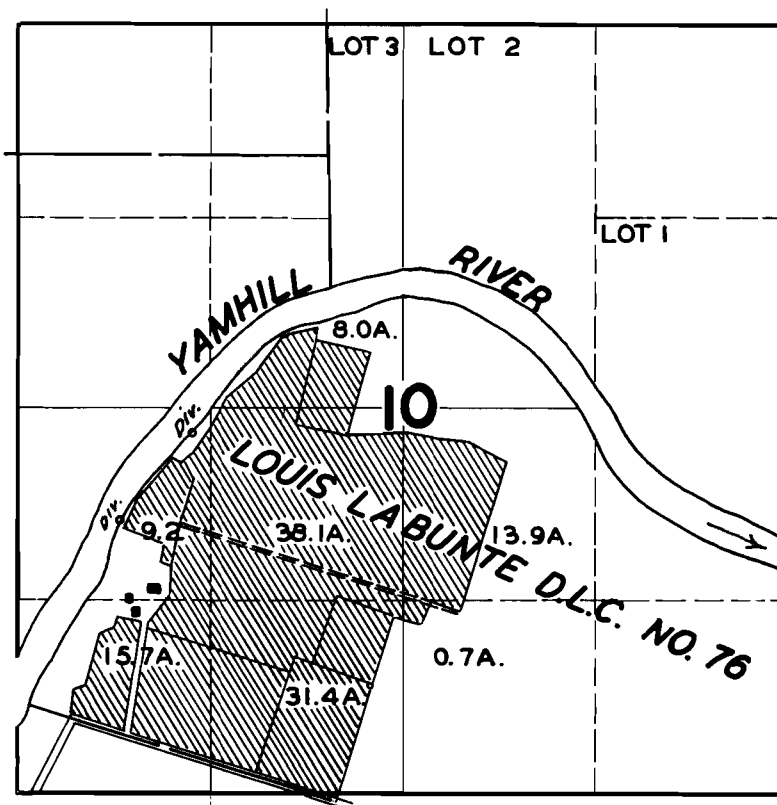

FINAL PROOF SURVEY

UNDER

Application No. **20418** ... Permit No. **15945** ...

IN NAME OF

WILLARD BROS.

Surveyed **JUNE 8, 1948**, by **JAS. E. BUNNELL**