


S.W. $\frac{1}{4}$ Section of Twp. 34S R1W

Map to Accompany Application for
Change in Point of Diversion.

For Robert K. Hammons and Mary
Scott Hammons.

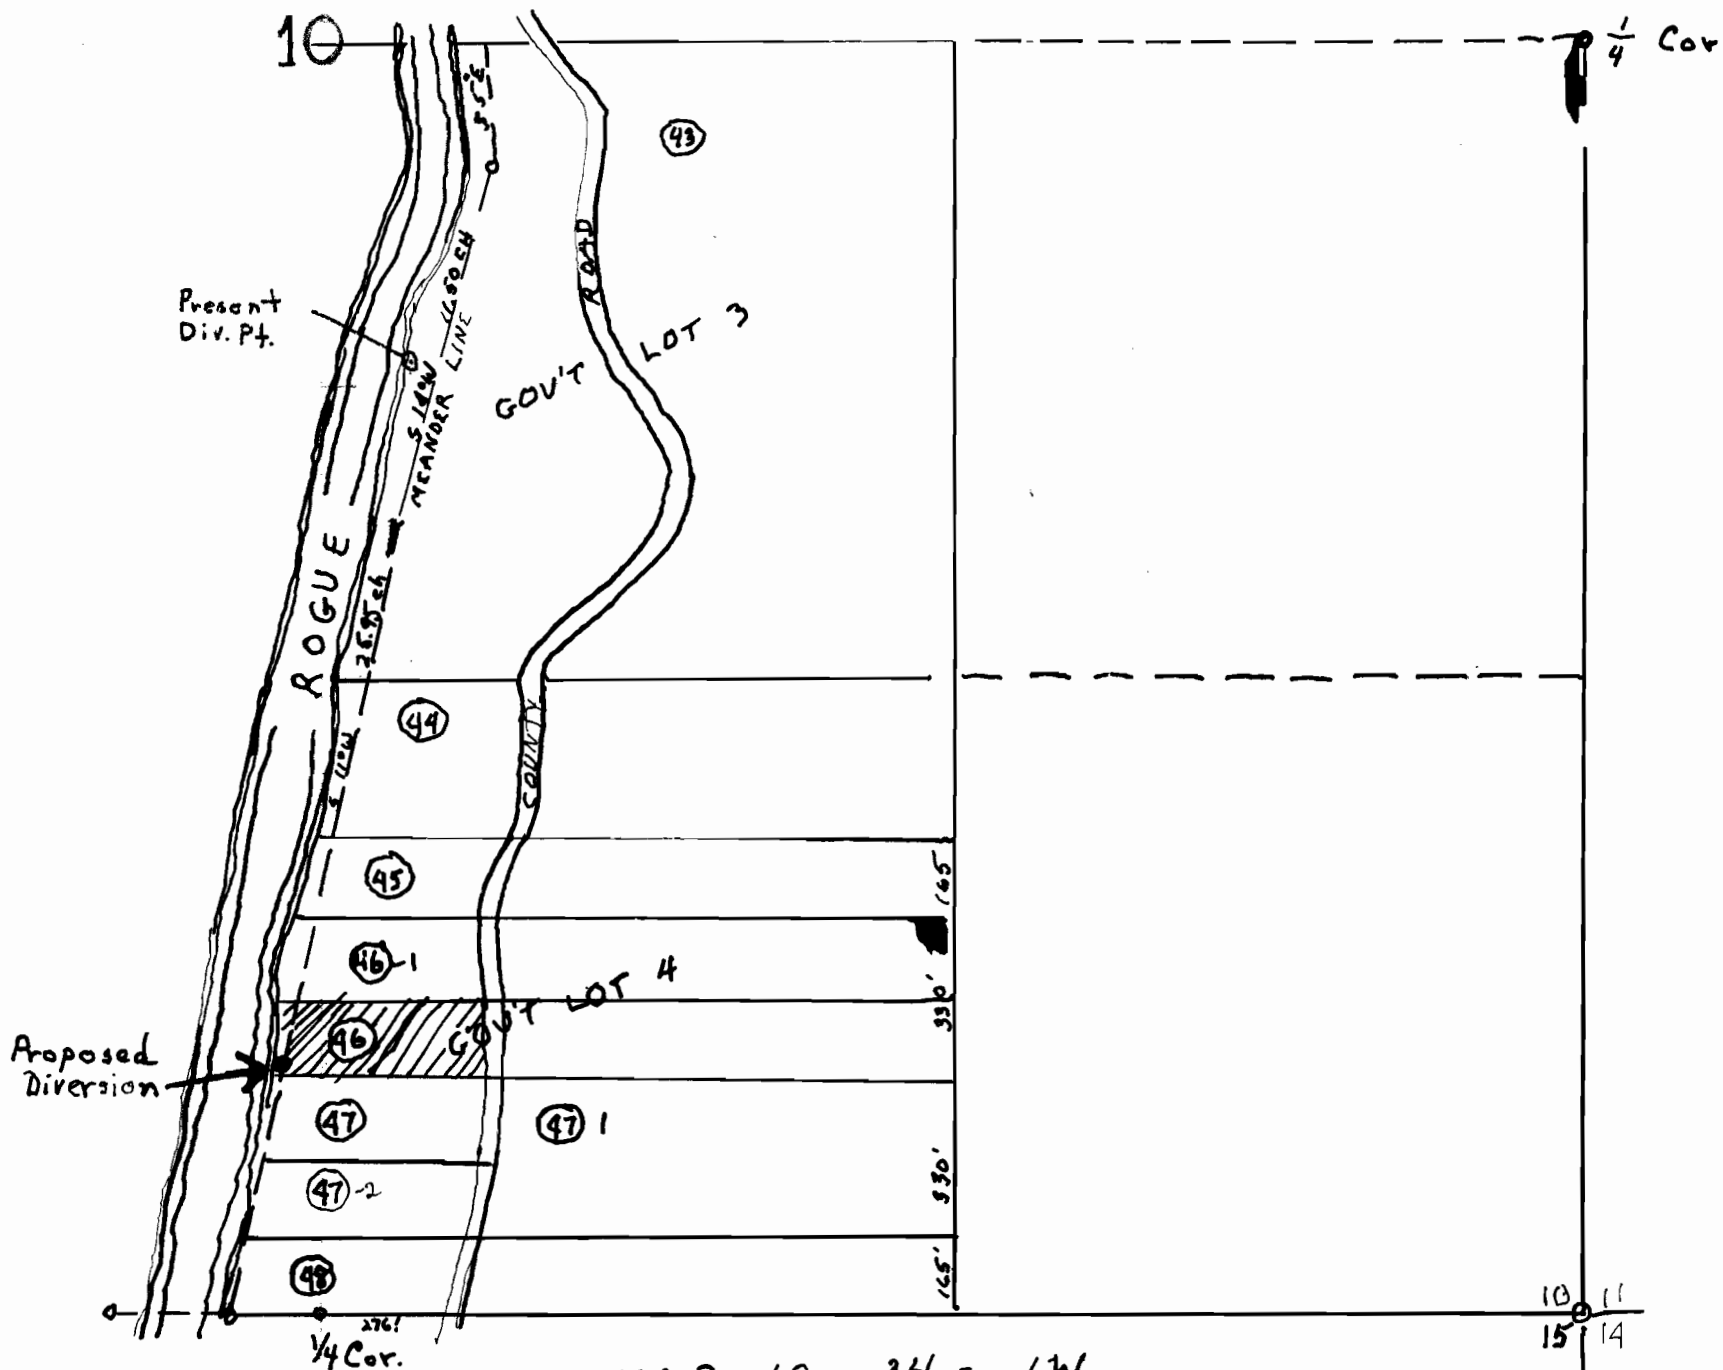

MAP 10-34-1W
Scale 1" = 400'

1/4-146