


T.17S.R.3 W.W.M.

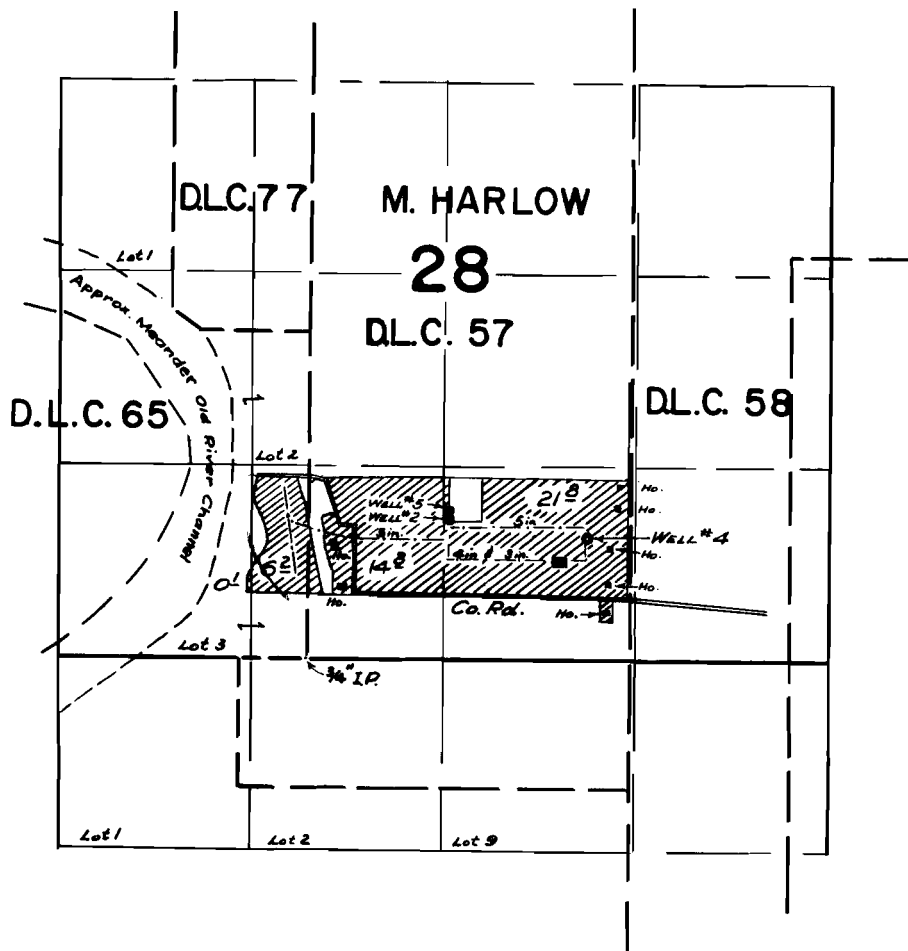

FINAL PROOF SURVEY
UNDER

Application No. G-1584 Permit No. G-1506
IN NAME OF

CHASE GARDENS

Surveyed 26 APRIL 1960, by M. A. B. [Signature]