


T. 27S. R. 6W. W. M.

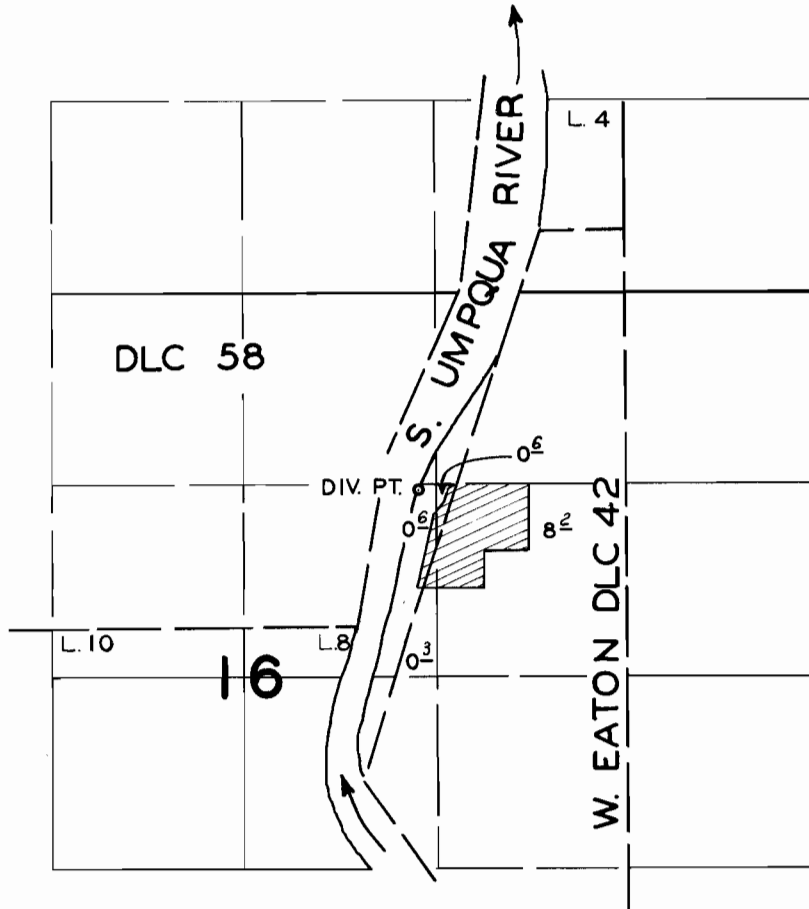

**FINAL PROOF SURVEY**  
UNDER

Application No. 28469 Permit No. 22296  
IN NAME OF

THOMAS C. NIEBUHR

Surveyed AUG. 25, 1960, by C. O. BARTELS