


T.7S. R.46E.W.M.

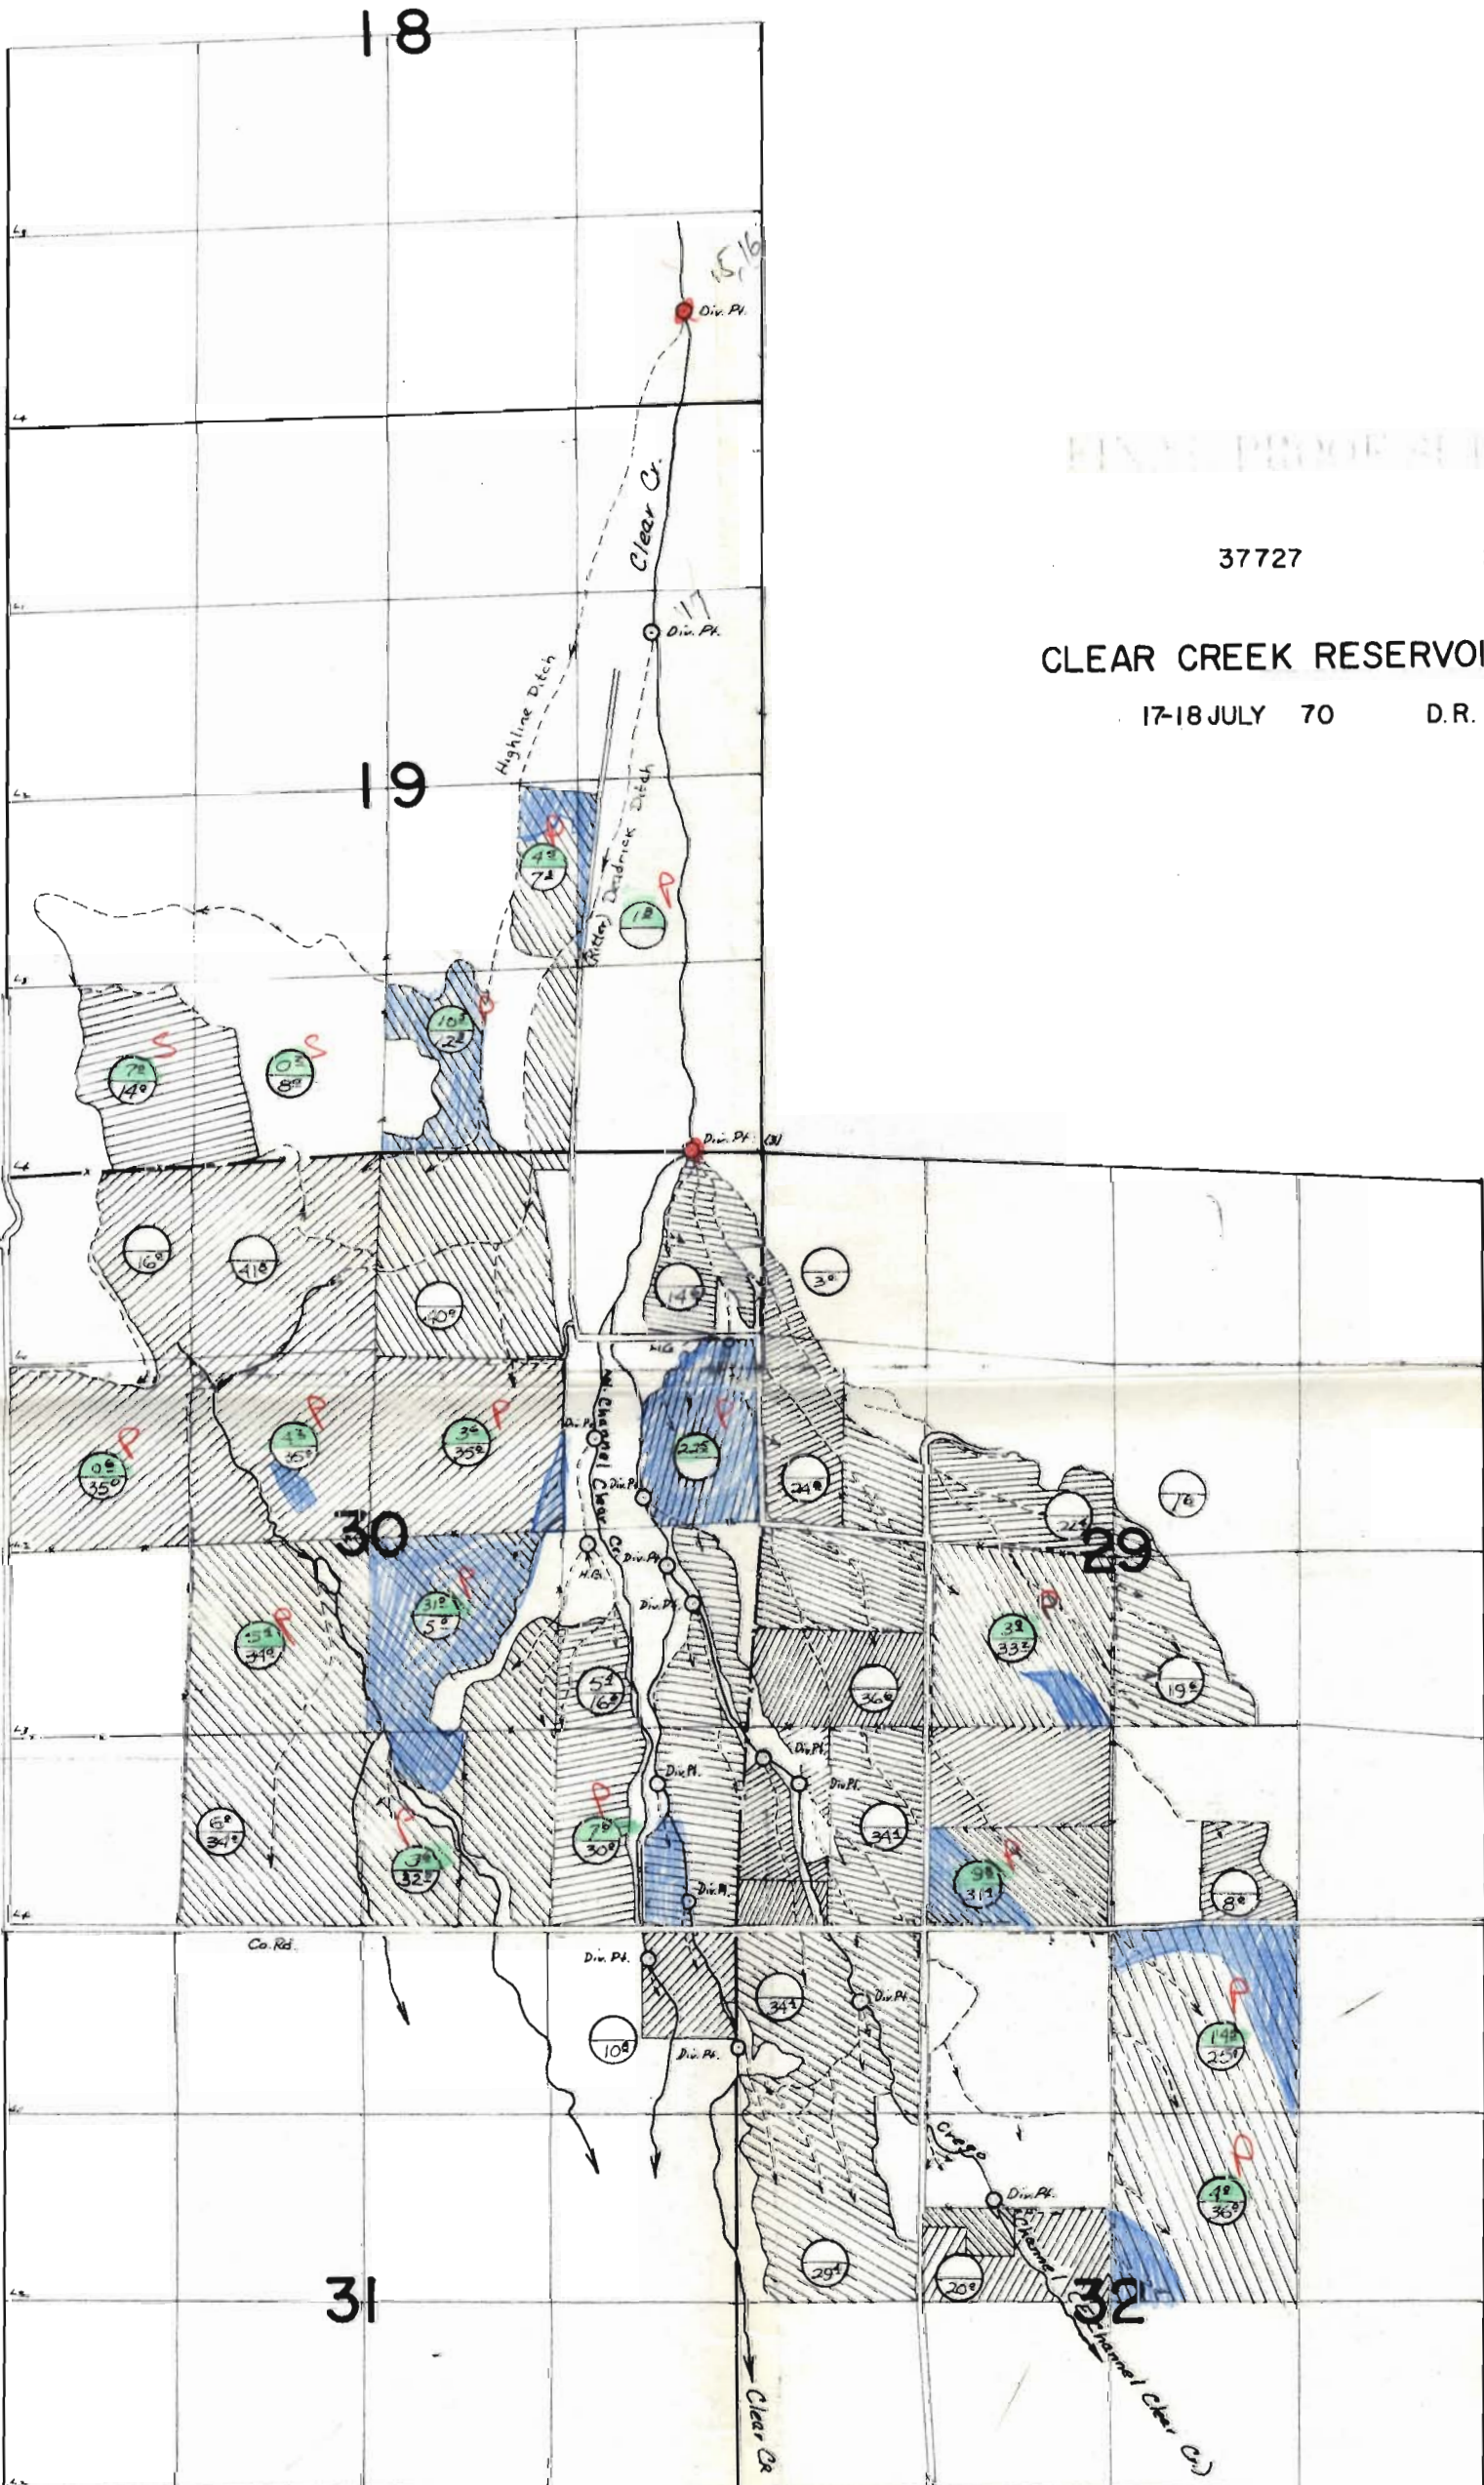

FINAL PROOF SURVEY

37727

28549

CLEAR CREEK RESERVOIR CO.

17-18 JULY 70

D. R. BUELL

Div. Pts. Loc. Main Channel Clear Cr. 11370' N & 4760' E, 9110' N & 4540' E, 74430' N & 4820' E, 3090' N & 4490' E, 2560' N & 4660' E, 1020' N & 4590' E, 200' N & 4810' E, 820' S & 5160' E, Grego (East) Channel Clear Cr. 2280' N & 4840' E, 1200' N & 5340' E, 1020' N & 5990' E, 500' S & 6020' E, 1920' S & 6080' E, West Channel Clear Cr. 2460' N & 4140' E, 190' S & 4530' E. all fm. SW. Cor. Sec. 30.

○ Permit 28549  
 Re: Clear Cr. Co. et al.