


**T. 7 S. R. 45 & 46 E. W.M.**

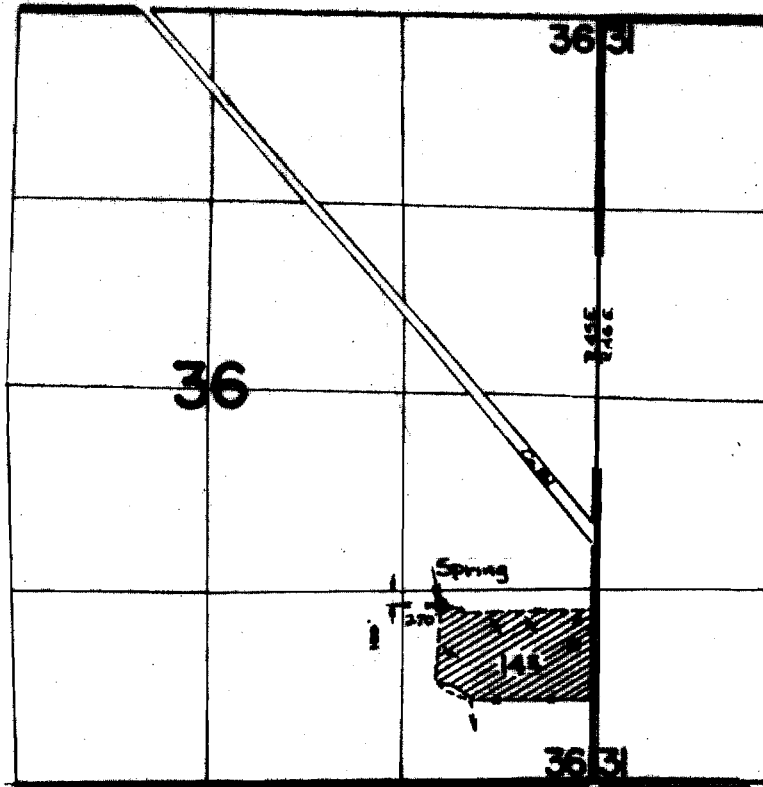


**FINAL PROOF SURVEY  
UNDER**

Application No. 40888... Permit No. 30288.....  
IN NAME OF

**WAYNE C. CHETWOOD**

Surveyed 18 JULY... 1970, by R.B. BUELL.....

T. 7 S. R. 45 & 46 E. W.M.

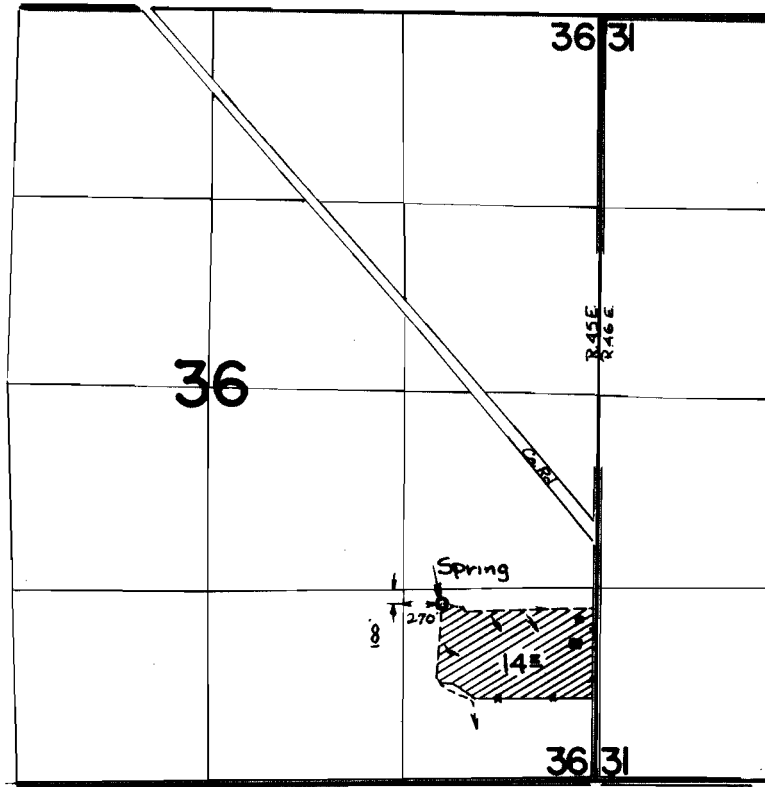

**FINAL PROOF SURVEY**  
UNDER

Application No. 40656..... Permit No. 30288.....  
IN NAME OF

.....WAYNE C. CHETWOOD.....

Surveyed 18 JULY 1970, by D. R. BUELL.....