


T. 9S. R. 40E. W.M.

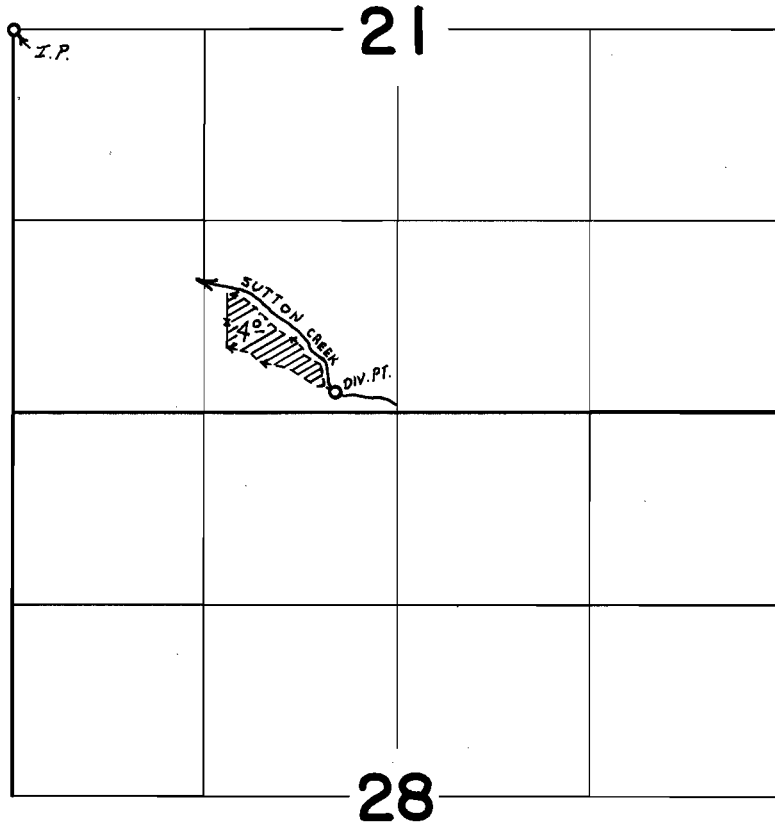

DIV. PT. LOC. 2990' S & 2210' E. FROM W 1/4 COR. SEC. 21

FINAL PROOF SURVEY UNDER

Application No. 42905 Permit No. 31669
IN NAME OF

GEORGE K. GUBLER

Surveyed JULY 23 1970, by L.E. GOULD