


T.8S.R.38&39E.W.M.

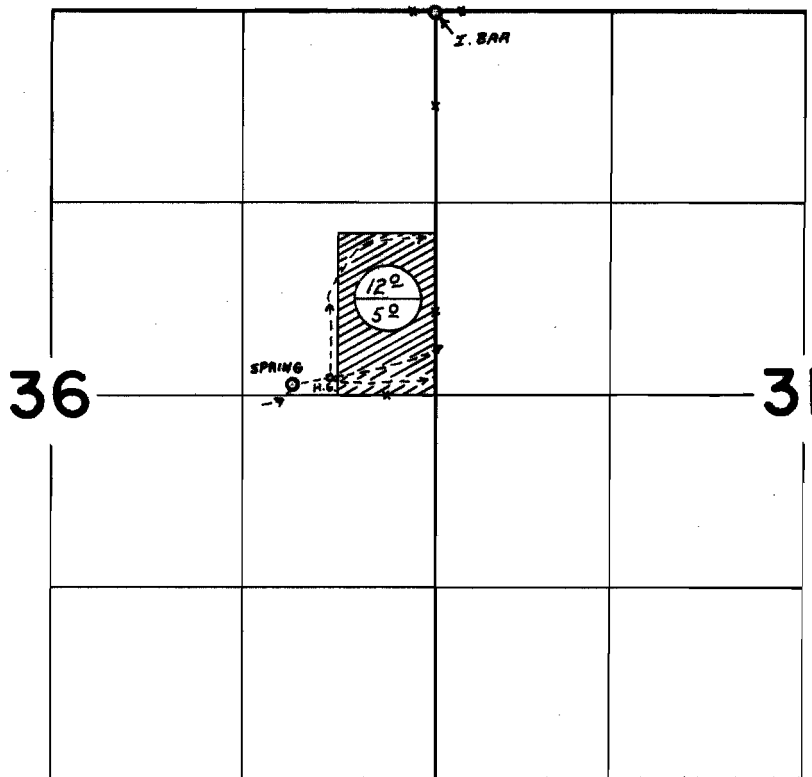

SPRING LOC. 2570'S. & 980'W. FROM NE COR. SEC. 36



PRIMARY
PRIOR RIGHT R-2212

FINAL PROOF SURVEY
UNDER

Application No. 45001 Permit No. 33631
IN NAME OF

DREXEL CALHOUN

Surveyed JULY 2 1970, by L.E. GOULD