


T. 14 S. R. 6 W. W. M.

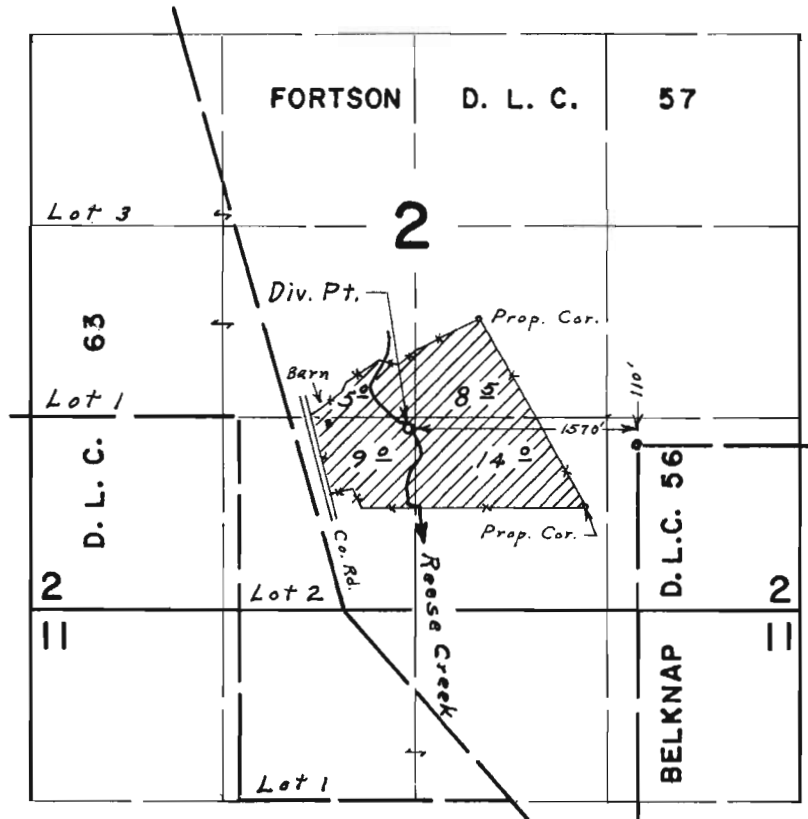

FINAL PROOF SURVEY

UNDER

Application No. 38786 Permit No. 28853

IN NAME OF

J. H. CLARK

Surveyed May 29, 1970, by L. E. Gould