


T. 14 S. R. 8 W. W. M.

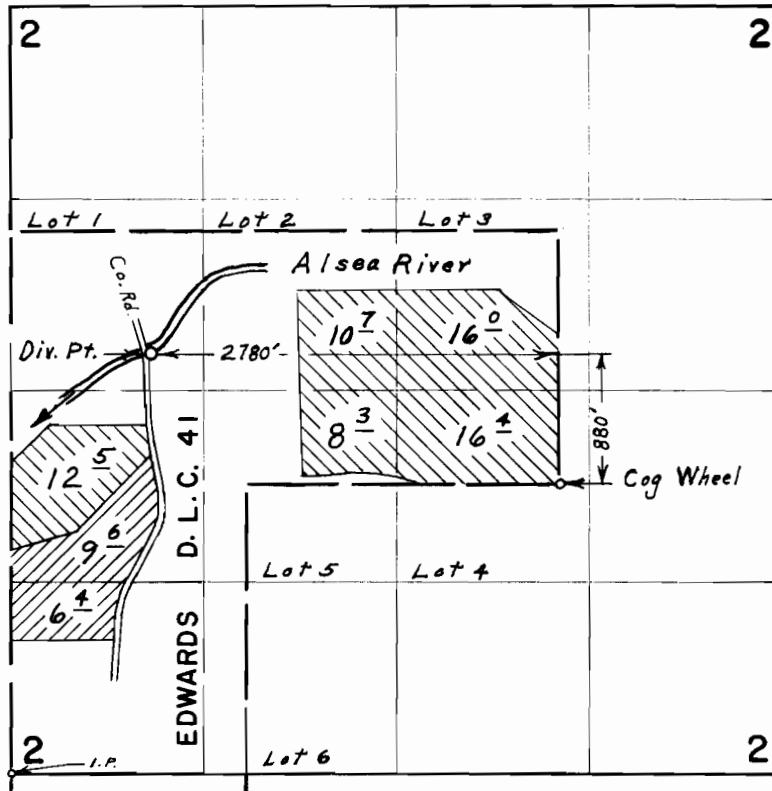

FINAL PROOF SURVEY UNDER

Application No. 41768 Permit No. 31177
 45224 33780
 IN NAME OF



DONALD LEE & KATHLEEN ROSE BOATWRIGHT

Surveyed Aug. 21., 1970. by L. E. Gould