T.2S.R.2E.W.M.

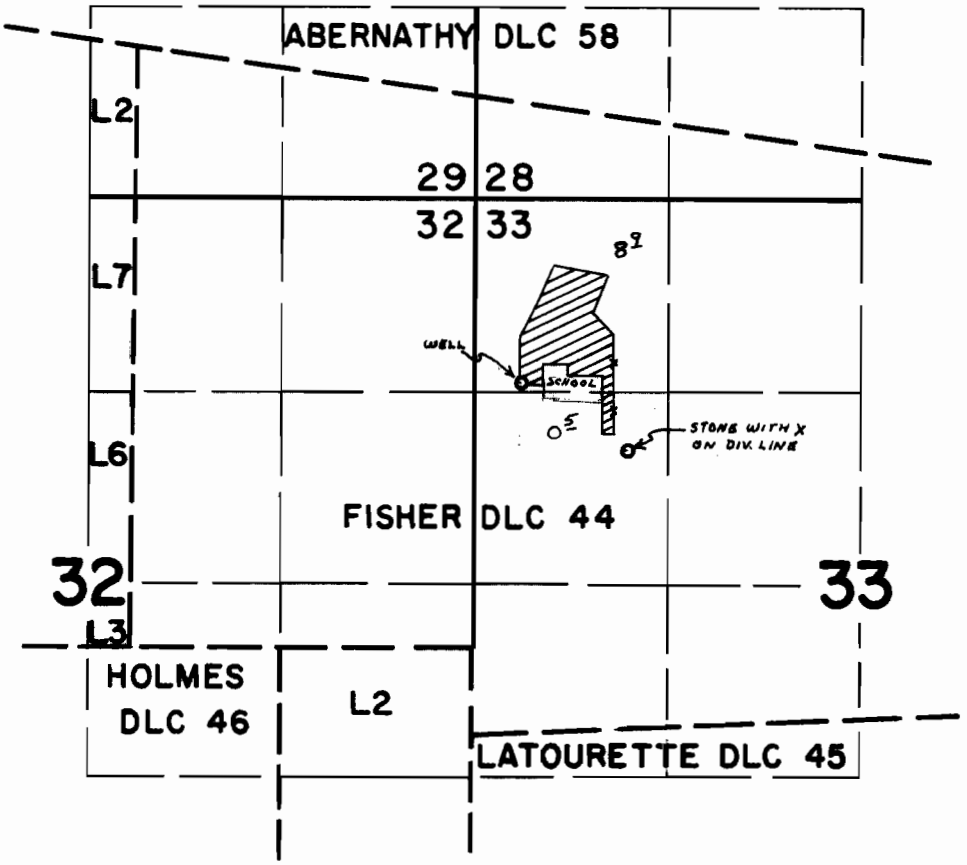

WELL LOC. 1820'N. & 2670'E. FROM SW COR. FISHER DLC 44

FINAL PROOF SURVEY
UNDER

Application No. G-3130 Permit No. G-3013
IN NAME OF

SCHOOL DISTRICT NO. 62

Surveyed SEPT. 10 1970, by G. BACA

1970-E