


# T.2S.R.2E.W.M.

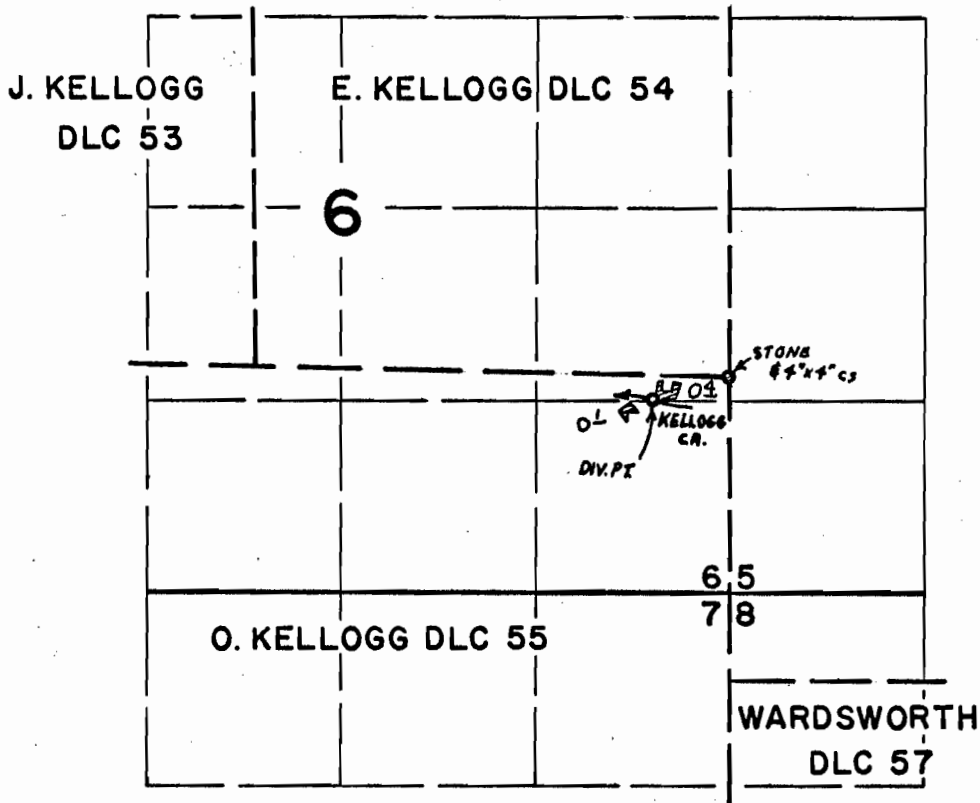

DIV. PT. LOC. 150'S. & 530'W. FROM NE COR. O. KELLOGG DLC 55

## FINAL PROOF SURVEY

UNDER

Application No. 39291 Permit No. 29359

IN NAME OF

WENDELL E. & MARIE G. BARRETT

Surveyed SEPT. 11, 1970, by G. BACA