


T. 2 S. R. 2 E. W. M.

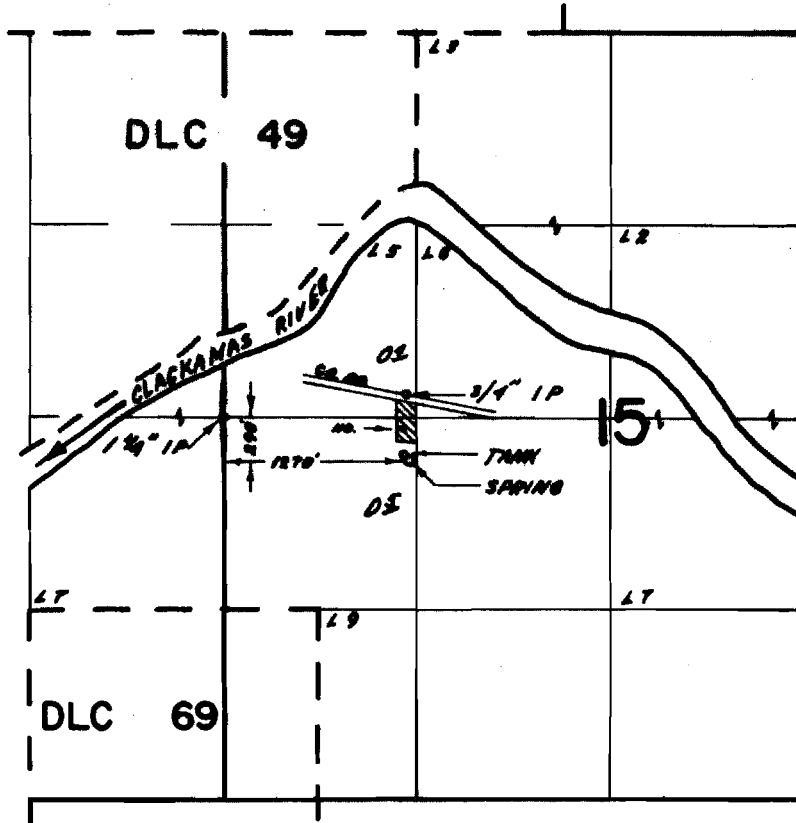

FINAL PROOF SURVEY UNDER

Application No. 42086... Permit No. 31495.....
IN NAME OF

ROBERT W. GROSSNICKLE.....

Surveyed SEP. 22., 1970, by G. BACA.....