


T.2S.R.2E.W.M.

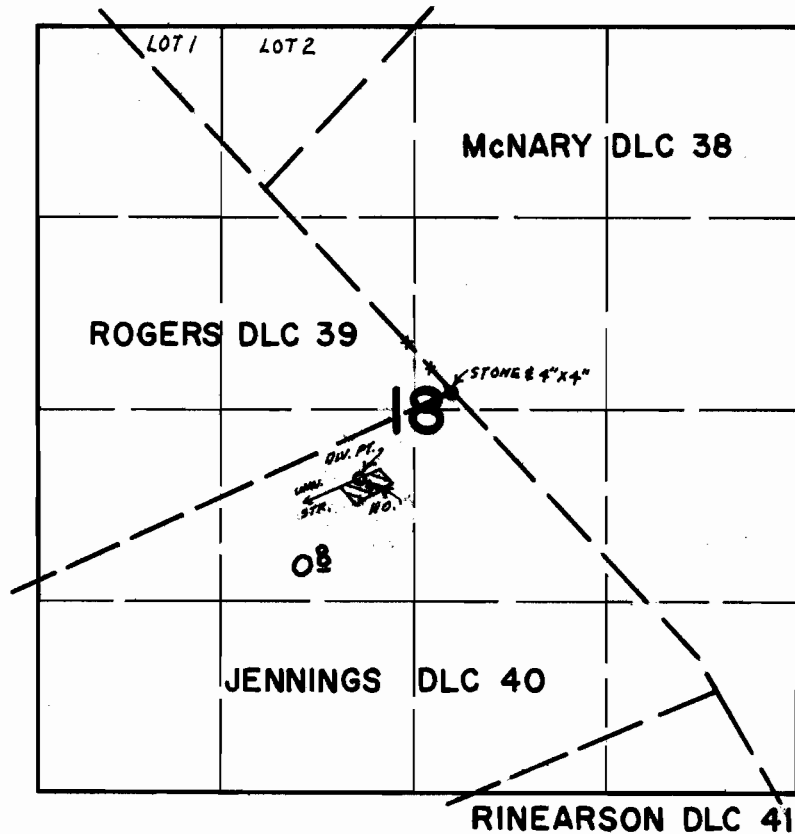

REF. PT. LOC. 590' S. & 630' W. FROM N. COR. JENNINGS DLC 40.

FINAL PROOF SURVEY

UNDER

Application No. 42330 Permit No. 31721

IN NAME OF

CARL J. MEZZIE

Surveyed SEPT. 11 19 70, by G. BACA