


T.3S.R.IE.W.M.

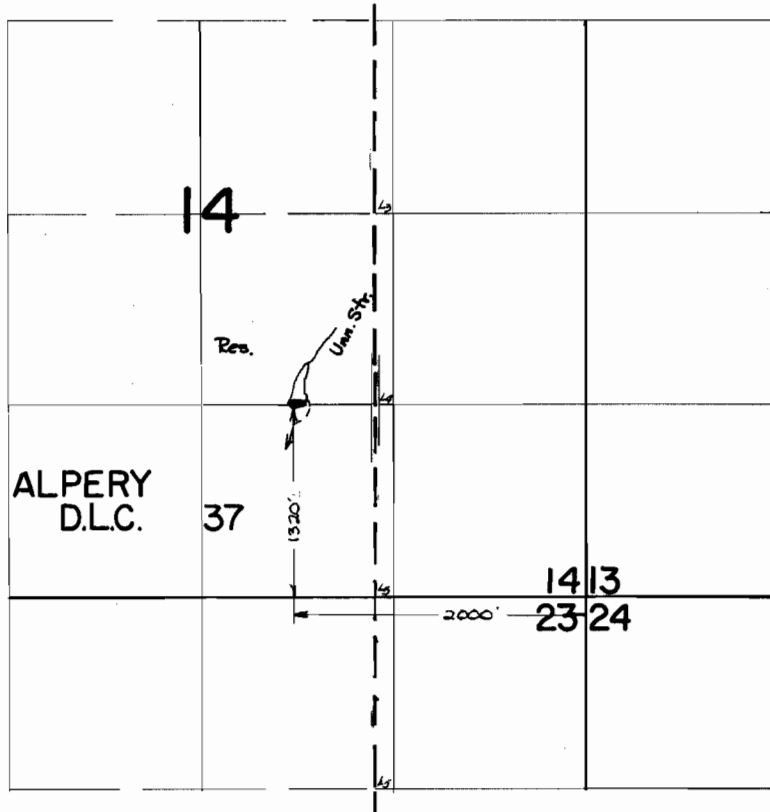

FINAL PROOF SURVEY UNDER

R 44449 R 5257
Application No. 44450 Permit No. 33246
IN NAME OF

PAUL ACKERMAN

Surveyed 21 AUG 1970 by D.R. BUELL