


T.30S. R.5W. W.M.

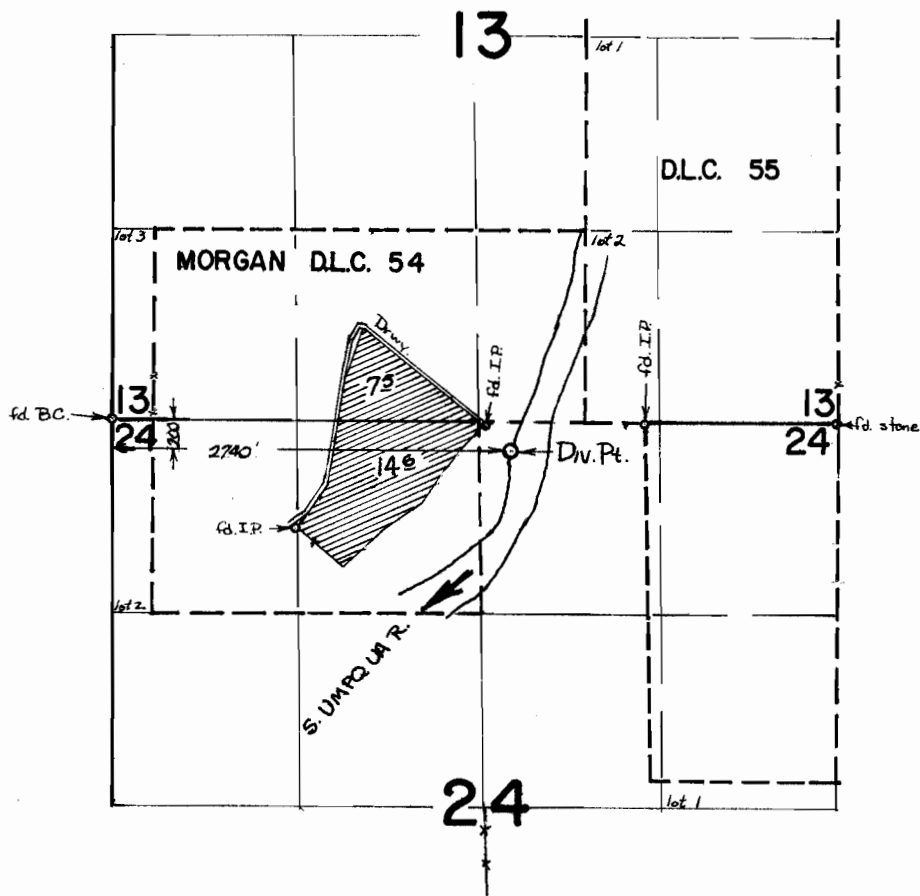

FINAL PROOF SURVEY

UNDER

Application No. 37541 Permit No. 27976

IN NAME OF

PETER E. ULAM

24 JUNE 69

Surveyed 2 JUNE 19 70, by D. R. BUELL