


T.28S.R.4W.W.M.

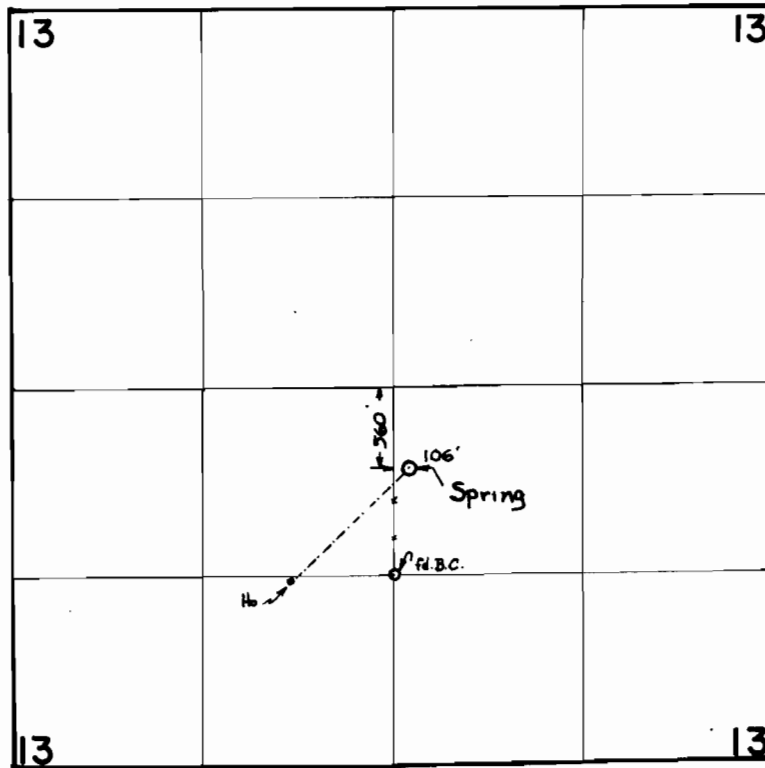

Spring loc. fm. applicant's map.

FINAL PROOF SURVEY

UNDER

Application No. 41352 Permit No. 30889

IN NAME OF

FLOYD GIESE

Surveyed 12 JUNE 1970, by D.R. BUELL