


T.29S. R.6 & 7W.W.M.

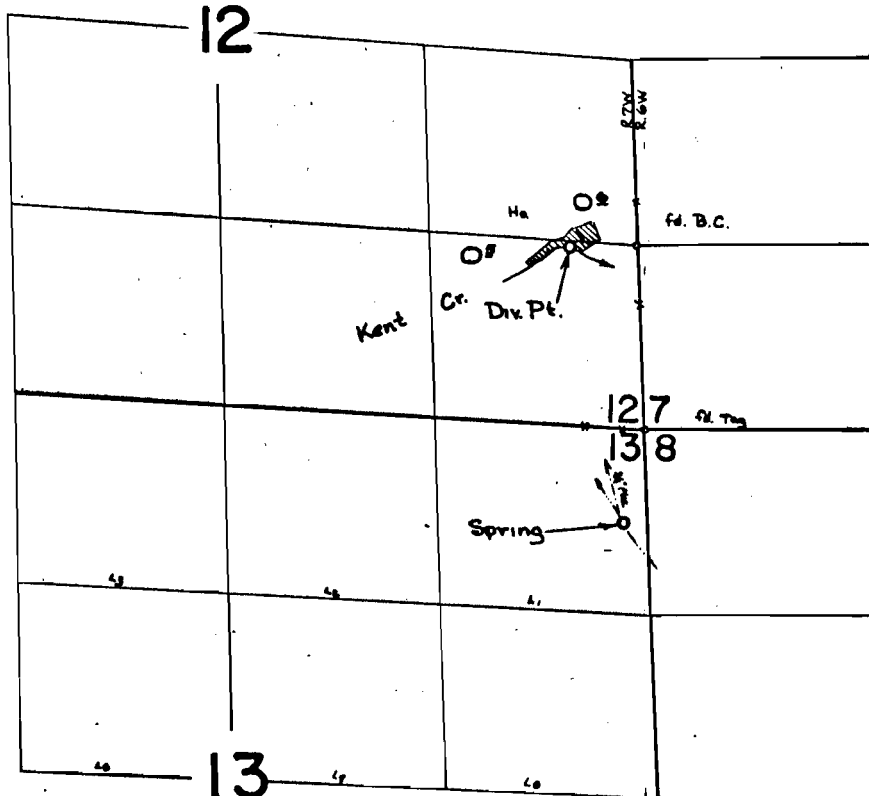

Dir. Pt. loc. 10'S & 440'W. from NE Cor. SE&SE¼ Sec. 12. Spring loc. 630'S & 150'W. from NE Cor. Sec. 13.

FINAL PROOF SURVEY UNDER

Application No. 44875 41873 Permit No. 33552 31327
IN NAME OF

PAUL A. & BARBARA C. WILSON

Surveyed 27 AUG 1970, by D.R. BUELL