


# T.29S.R.6 & 7W.W.M.

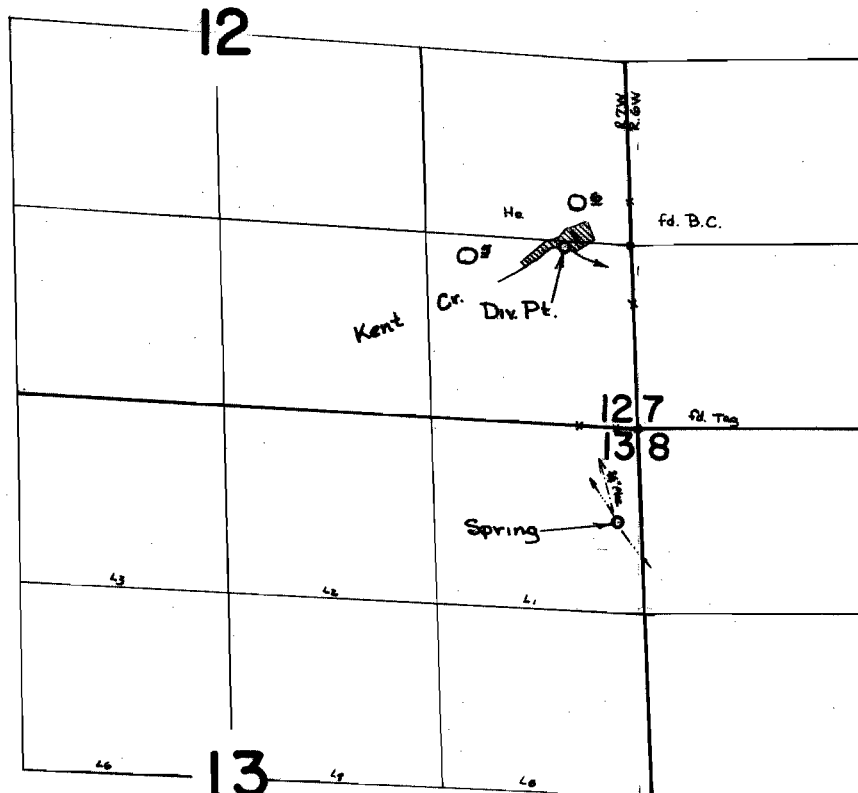

Div. Pt. loc. 10'S & 440'W. fm NE Cor. SE4SE4 Sec. 12. Spring loc. 630'S & 150'W. fm NE Cor. Sec. 13.

## FINAL PROOF SURVEY UNDER

Application No. 44875 41873 Permit No. 33552 31327  
IN NAME OF

PAUL A. & BARBARA C. WILSON

Surveyed 27 AUG 1970, by D.R. BUELL