


T. 32 S. R. 6 W. W.M.

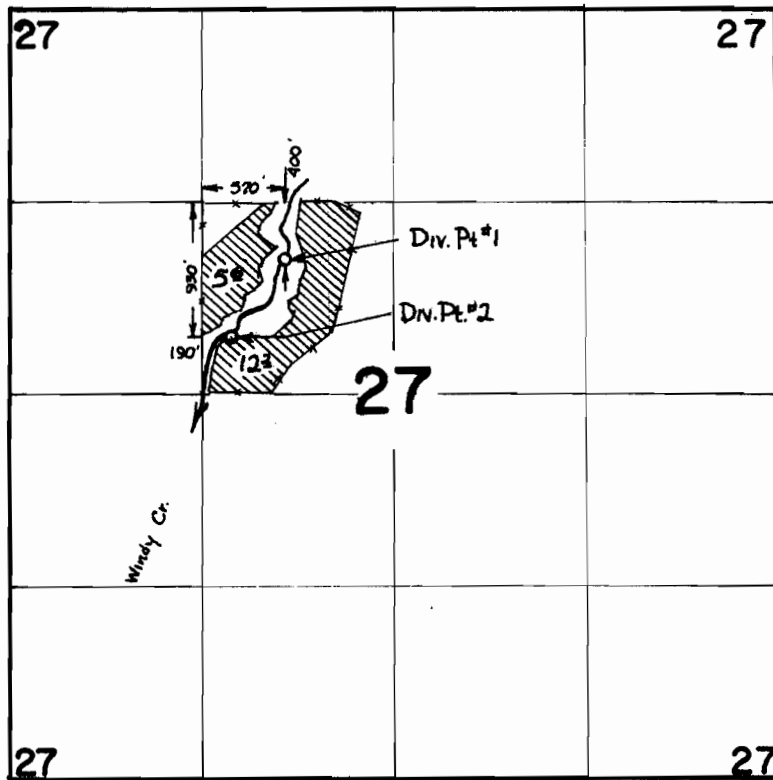

FINAL PROOF SURVEY

UNDER

Application No. 42427 Permit No. 31746

IN NAME OF

J. D. SANDERS

Surveyed 4 JUNE 1970, by D. R. BUELL