


# T.29S. R.3W.W.M.

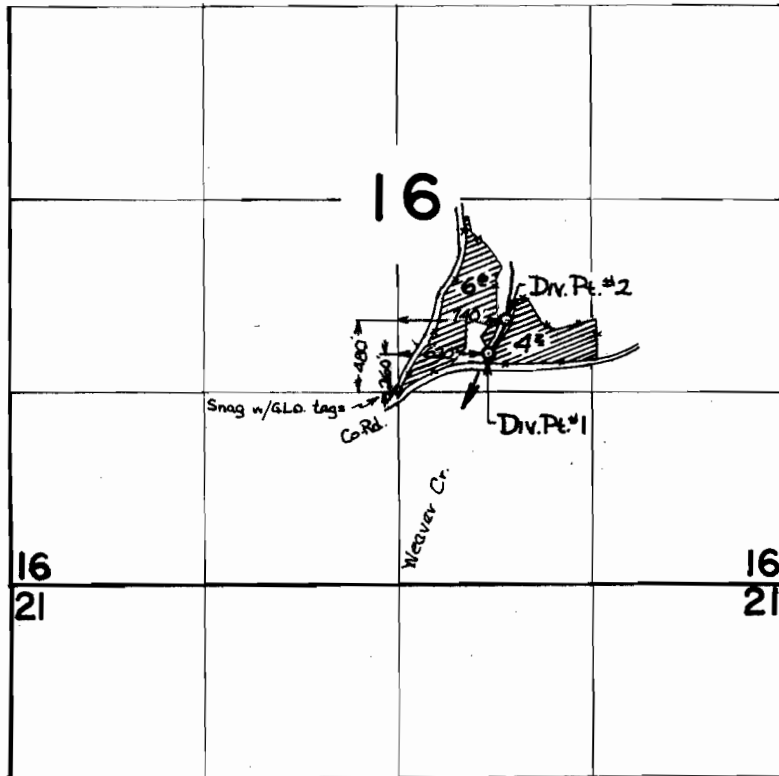

## FINAL PROOF SURVEY

UNDER

Application No. 42517 Permit No. 31775

IN NAME OF

PERRY L. MURRAY

Surveyed 11 JUNE 1970, by D. R. BUELL