


T.29 S. R. 8 W W.M.

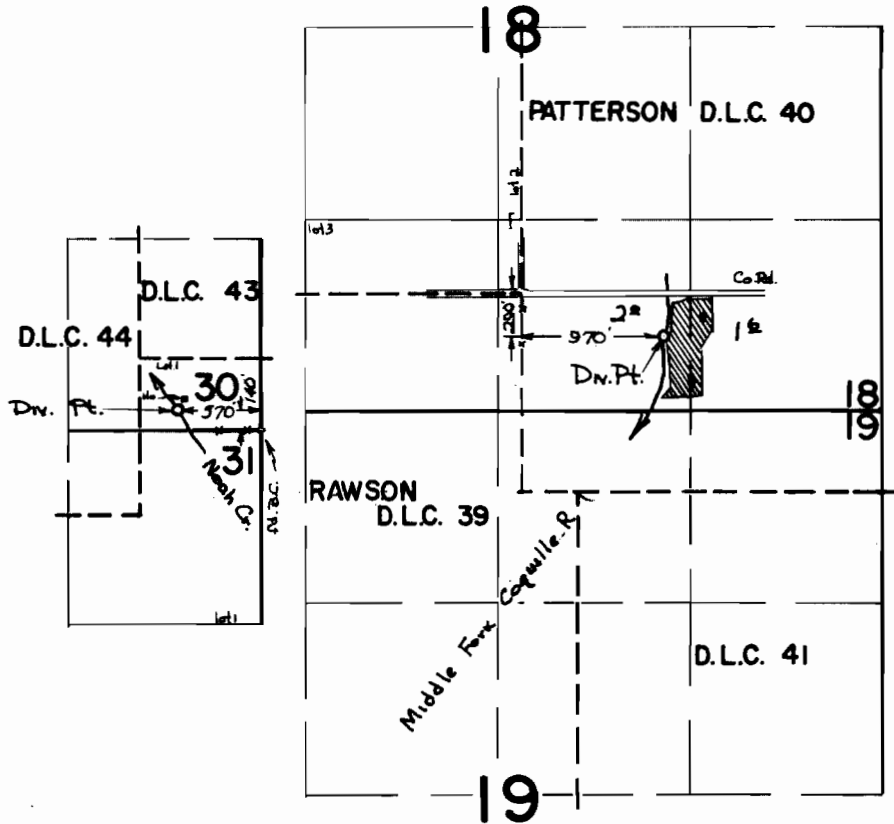

FINAL PROOF SURVEY UNDER

Application No. 43418..... Permit No. 32461.....
IN NAME OF

NOBLE STANDLEY

Surveyed 25.AUG... 1970., by D.R. BUELL.....