


T. 27 S. R. 6 W. W.M.

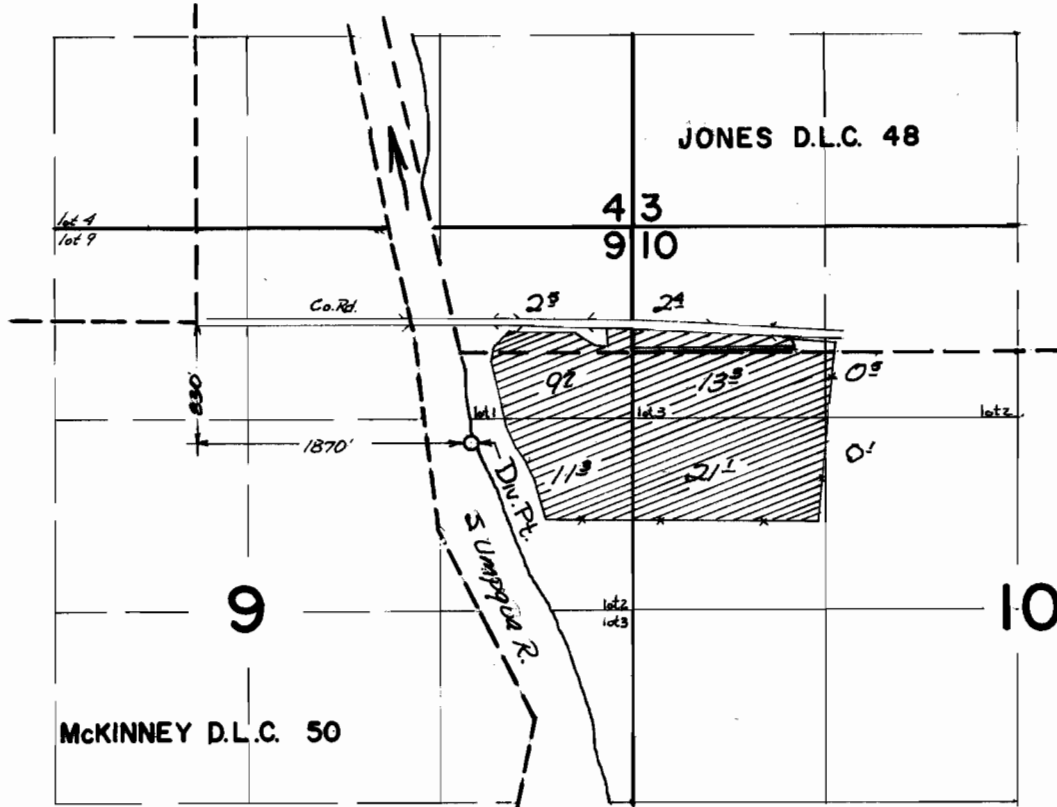

FINAL PROOF SURVEY

UNDER

Application No. **44539** Permit No. **32876**

IN NAME OF

C. C. LAURANCE

Surveyed **24 AUG 19 70**, by **D. R. BUELL**