


T.27 & 28S. R. 4 & 5W. W.M.

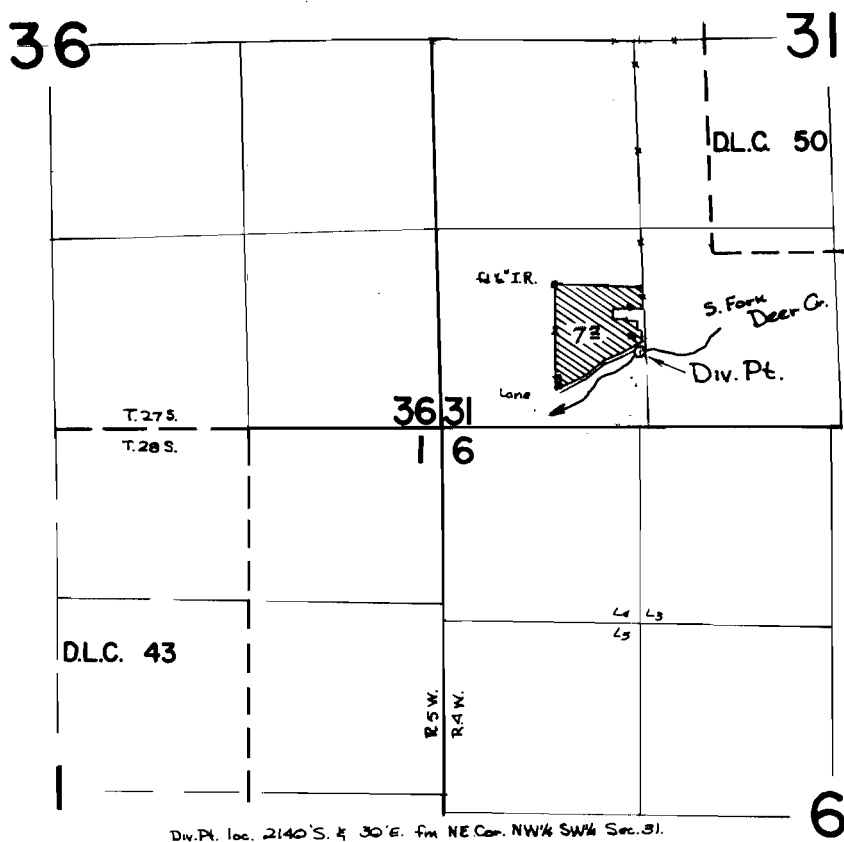

FINAL PROOF SURVEY
UNDER

Application No. 43985 Permit No. 32882
IN NAME OF

DON HEIL

Surveyed 28 AUG. 1970, by D.R. BUELL