


T.28 S. R. 6 W. W.M.

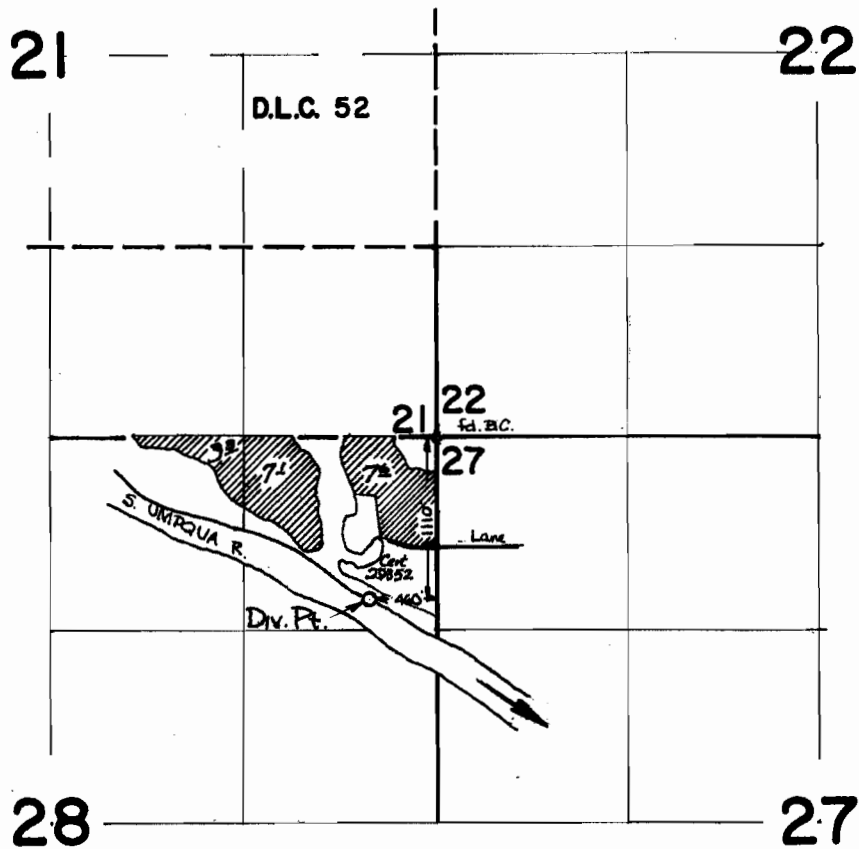

FINAL PROOF SURVEY

UNDER

Application No. 44282 Permit No. 33075

IN NAME OF

J. B. KNAEBEL

Surveyed 16 JUNE 1970, by D. R. BUELL