


T.29S. R.4W. W.M.

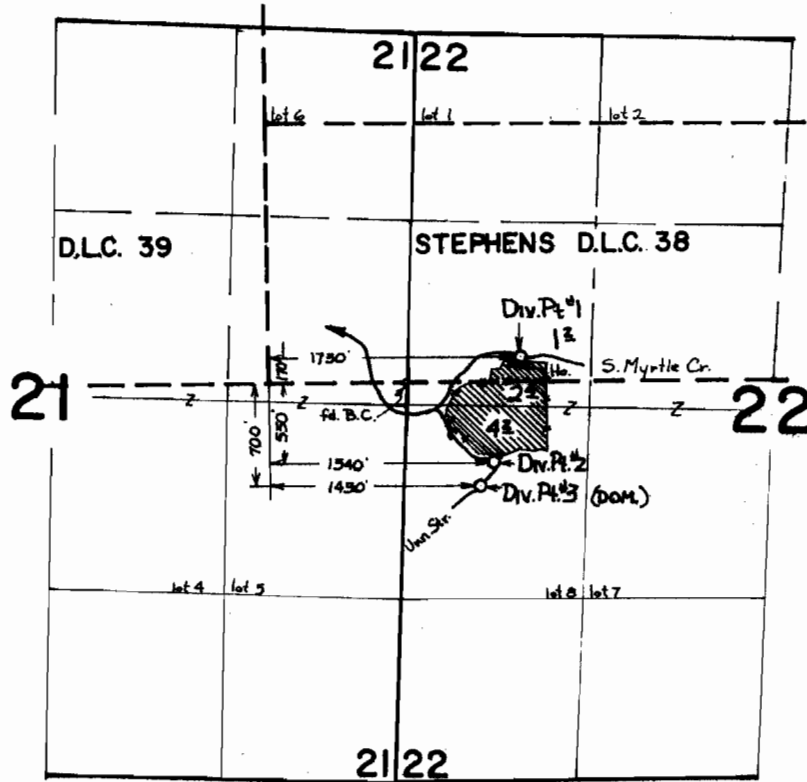

FINAL PROOF SURVEY

UNDER

Application No. 44531 Permit No. 33320

IN NAME OF

DARRELL MCGARVEY

Surveyed 11 JUNE 1970, by D. R. BUELL