


T.29 S.R.4W.W.M.

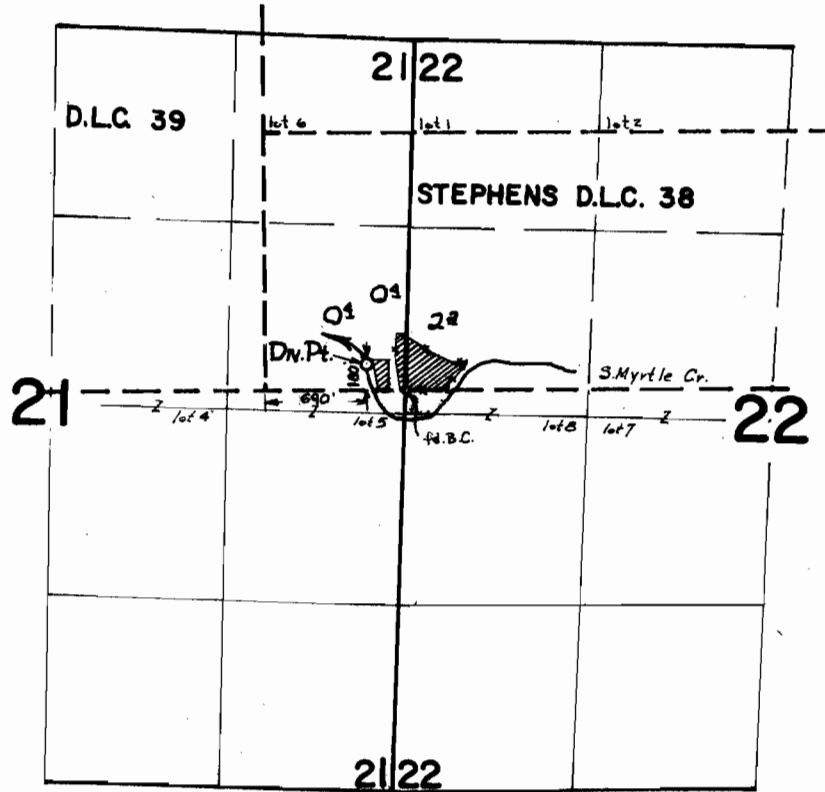

FINAL PROOF SURVEY

UNDER

Application No. **44558** Permit No. **33351**

IN NAME OF

FRANK P. & CLARA A. MOAN

Surveyed **11 JUNE 1970**, by **D. R. BUELL**