


T. 30 S. R. 3 W. W.M.

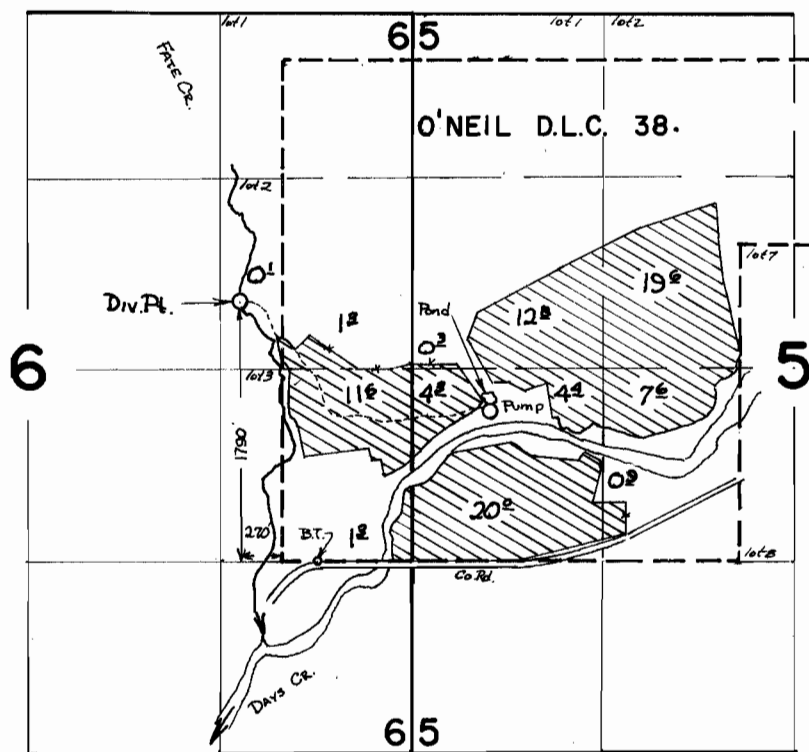

FINAL PROOF SURVEY

UNDER

44956 Permit No. 33602

IN NAME OF

FATE CREEK RANCH CORP.

Surveyed **2 JUNE 1970**, by **D. R. BUELL**