


T. 31 S. R. 1 & 2 W. W.M.

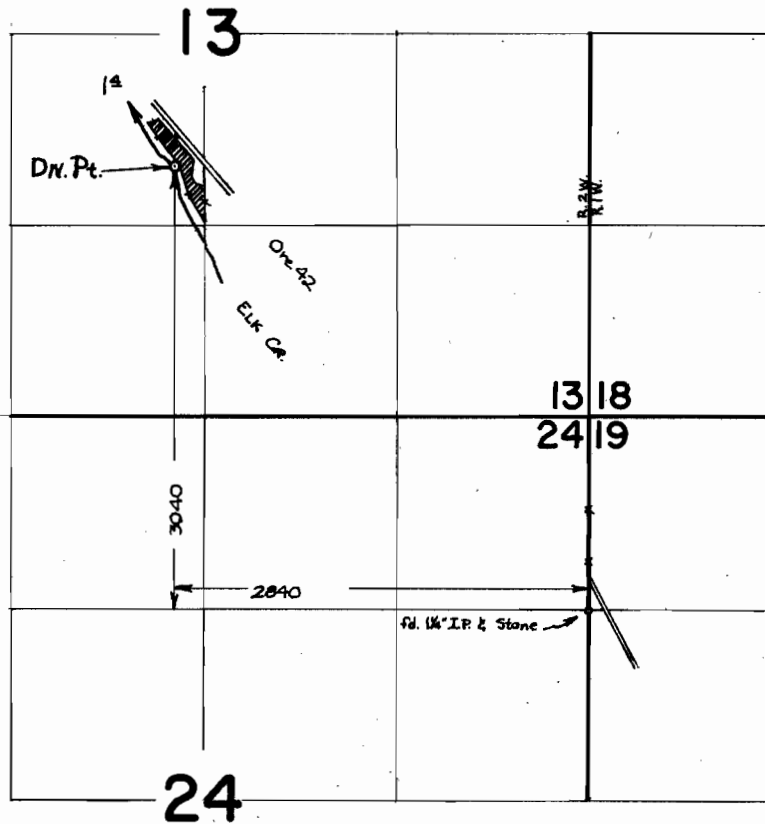

FINAL PROOF SURVEY

UNDER

Application No. 45616 Permit No. 34026

IN NAME OF

TED & VIOLA GARDNER

Surveyed 3 JUNE 1970, by D. R. BUELL