


# T. 29S. R. 4 & 5 W.W.M.

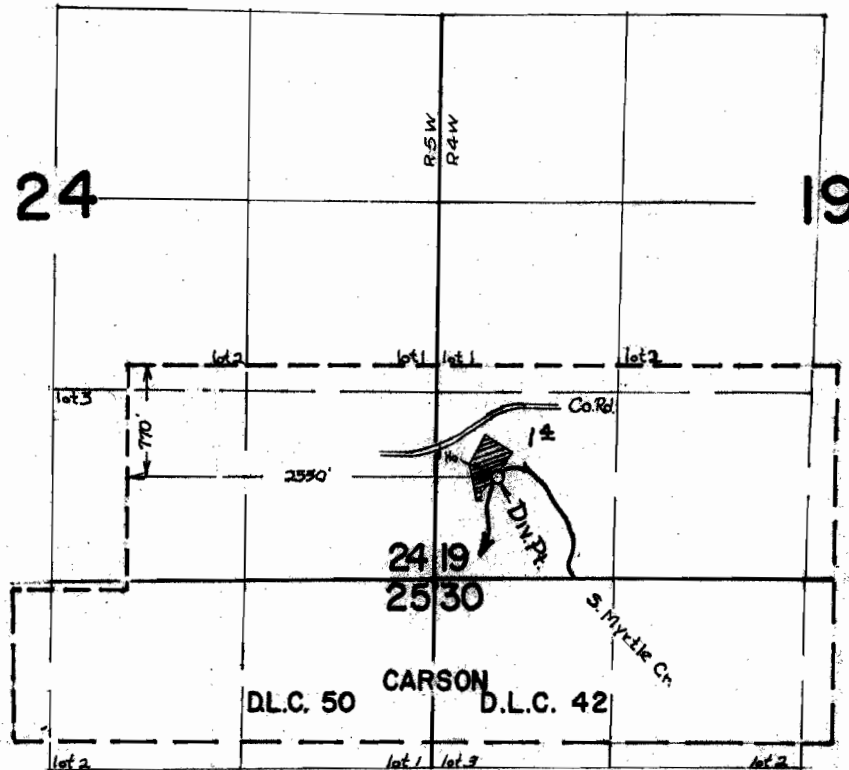

## FINAL PROOF SURVEY

UNDER

Application No. 45653 Permit No. 34046

IN NAME OF

C. E. TOTUSHEK

Surveyed 11 JUNE 1970, by D. R. BUELL