

OAK GROVE PARK


SECTIONS 20.21, T27S, R4W, W.M.

DOUGLAS COUNTY, OREGON

BEN B. IRVING REG. CIVIL ENGINEER

ROSEBURG, OREGON.

SCALE 1"=100'

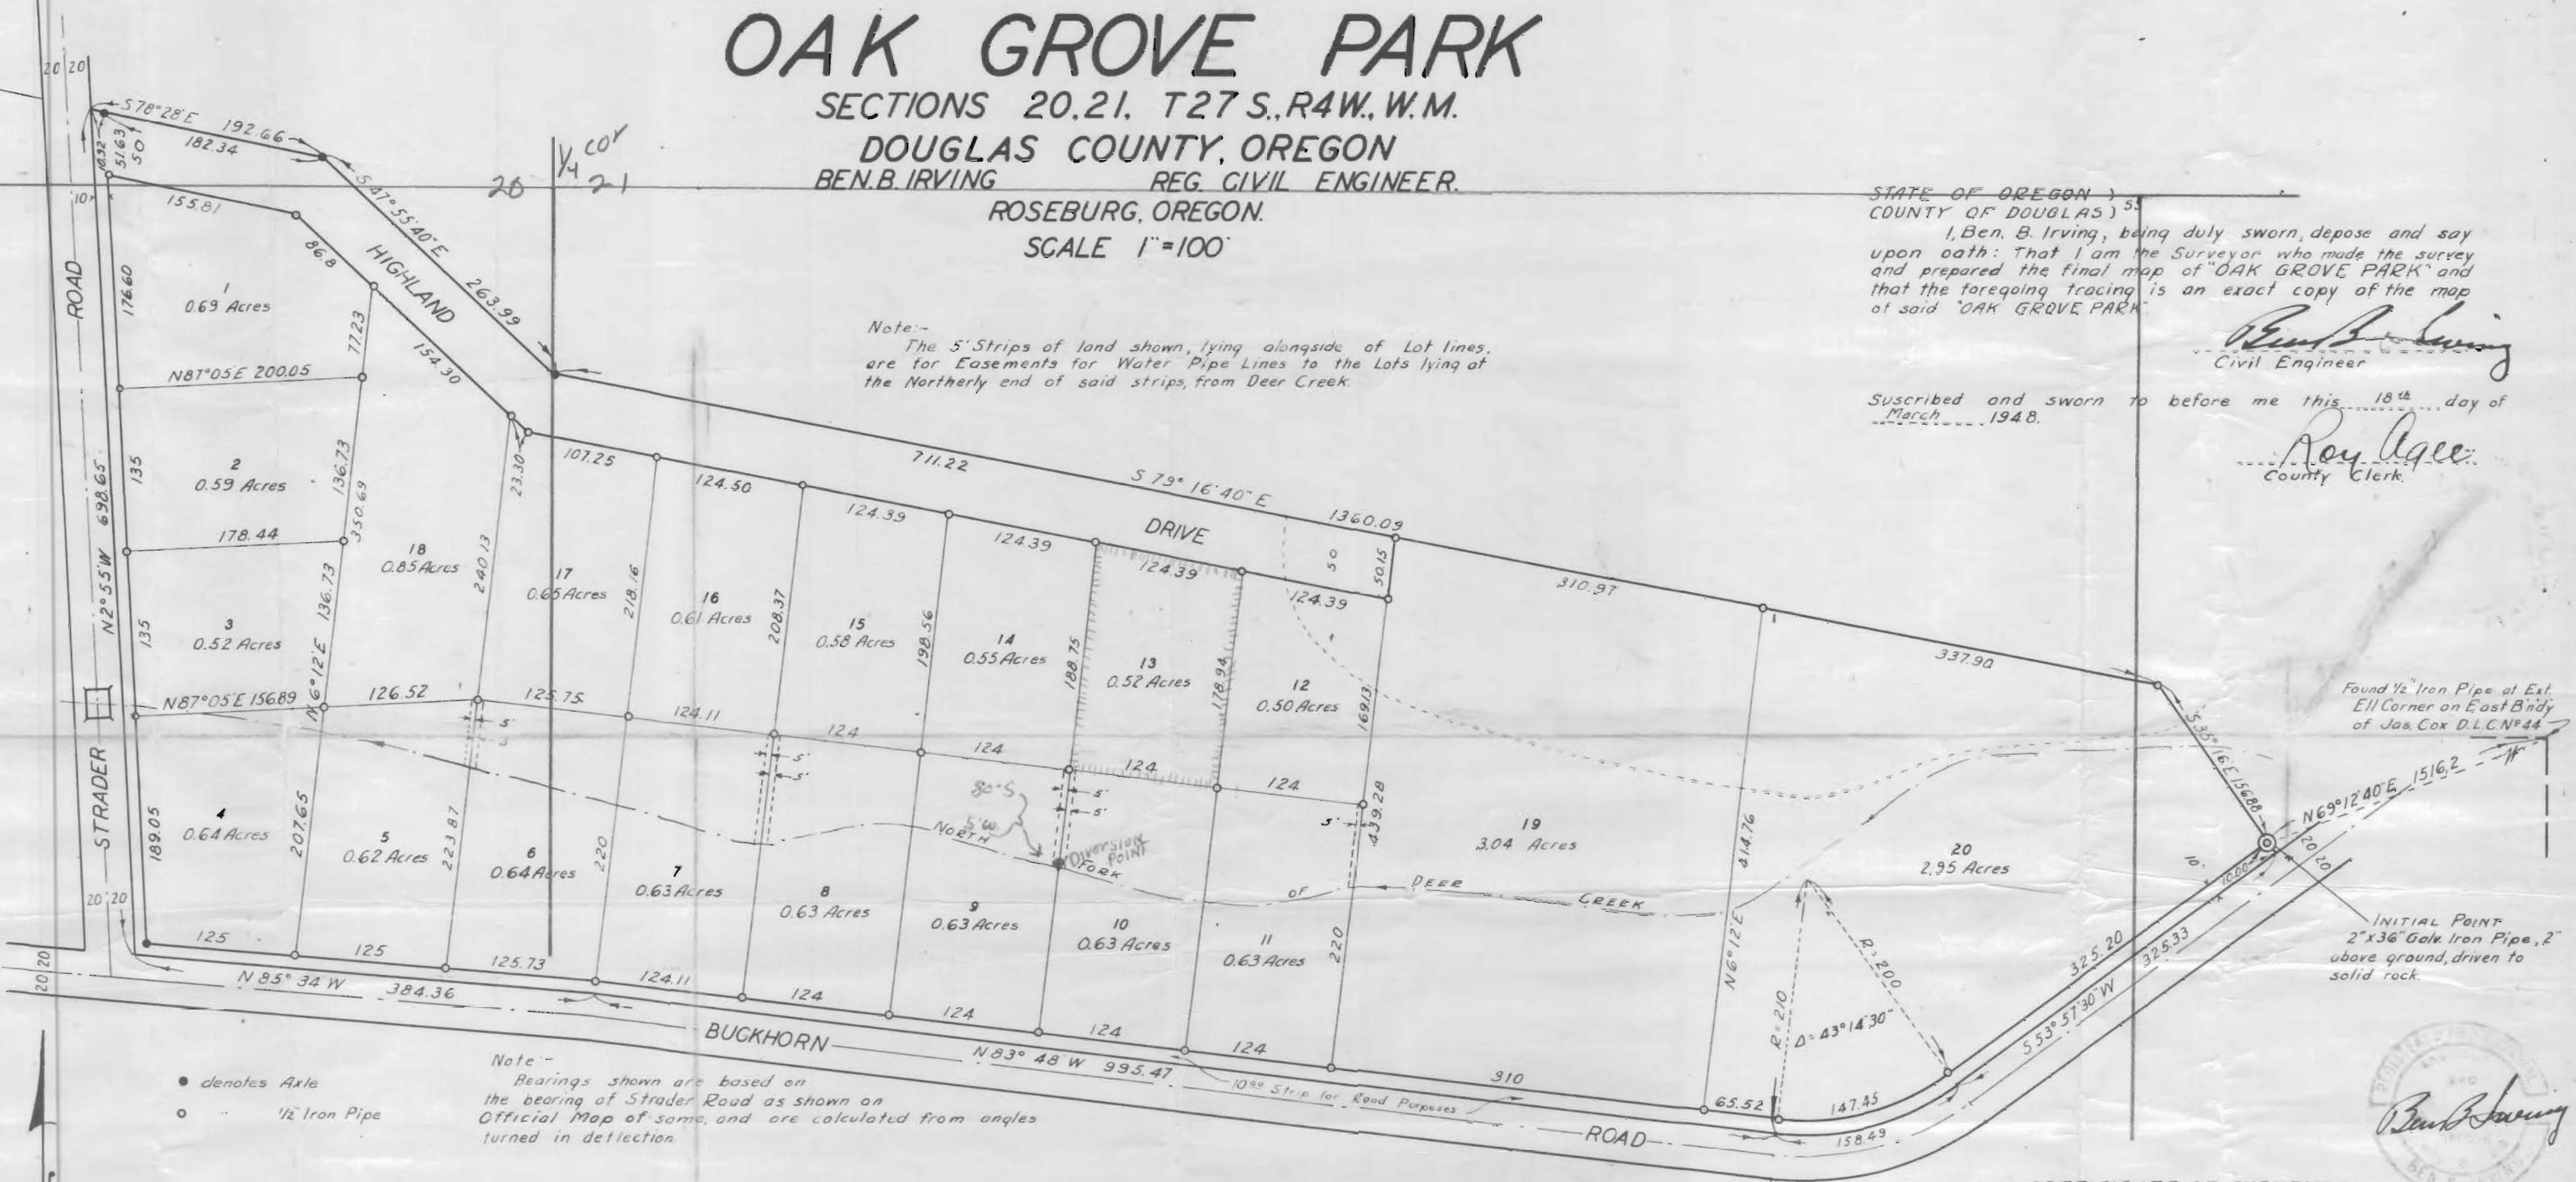

DEDICATION

KNOW ALL MEN BY THESE PRESENTS that WE, G.A. Lindblom and Hattie C. Lindblom, Husband and Wife, owners of the lands represented and described on the annexed plat, have caused the same to be surveyed and platted by the name of "OAK GROVE PARK", and we hereby dedicate to the use of the public forever, the road shown thereon.

IN TESTIMONY WHEREOF, the said G.A. Lindblom and Hattie C. Lindblom have hereunto set their hands, this 18th day of March 1948.

G.A. Lindblom
Hattie C. Lindblom

Hattie C. Lindblom

APPROVED March 19 1948

D.B. Busenbark
COUNTY JUDGE

APPROVED 19 March 1948

Ned Dixon
COUNTY ASSESSOR

ACKNOWLEDGEMENT

STATE OF OREGON 1948
COUNTY OF DOUGLAS

On the 18th day of March 1948, before me appeared G.A. Lindblom and Hattie C. Lindblom, to me personally known, who being duly sworn, did say that they are the lawful owners of the tract of land delineated on the annexed plat, and that they do hereby acknowledge that they signed the accompanying dedication as their free and voluntary act and deed.

IN TESTIMONY WHEREOF, I have hereunto set my hand and affixed my official seal this day and year above written.

Roy Ague
COUNTY CLERK

CERTIFICATE OF SURVEYOR

STATE OF OREGON 1948
COUNTY OF DOUGLAS

I, Ben B. Irving, being first duly sworn, depose and say that I have correctly surveyed and marked with proper monuments the lands delineated on the annexed plot, of which the following is a true and correct description: Beginning at a 2"x36" Galv. 

Oregon No 240.
November 8, 1948.

Ben B. Irving
Registered Professional Engineer

APPROVED March 19 1948

Ben B. Irving
COUNTY SURVEYOR

Suscribed and sworn to before me this 18th day of March 1948.

Roy Ague

FILED March 19th 1948

Roy Ague
COUNTY CLERK