


T. 35S. R. 2W. W.M.

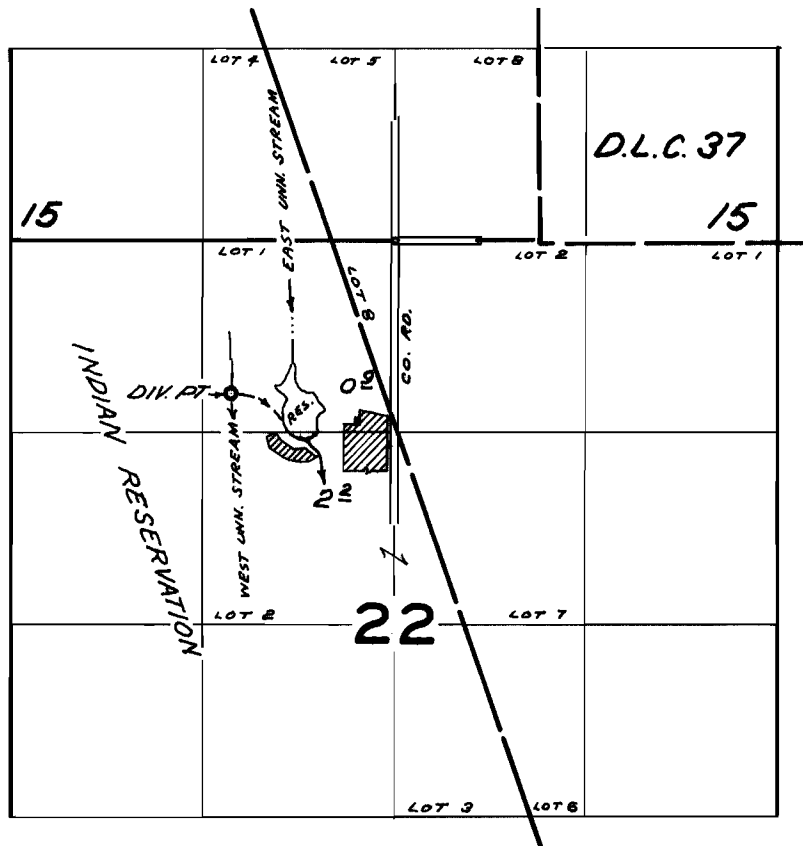

DIV. PTS. LOCATED: 1050' S. & 1130' W.; 1370' S. & 630' W.; BOTH FROM N. 1/4 COR. SEC 22

FINAL PROOF SURVEY
UNDER

Application No. 38610 Permit No. 28747
R-38615 R-3252
IN NAME OF

ELZA W. DESPAIN

Surveyed JUN 14 1968, by V. GARNER