


T. 38 S. R. 8 W. W.M.

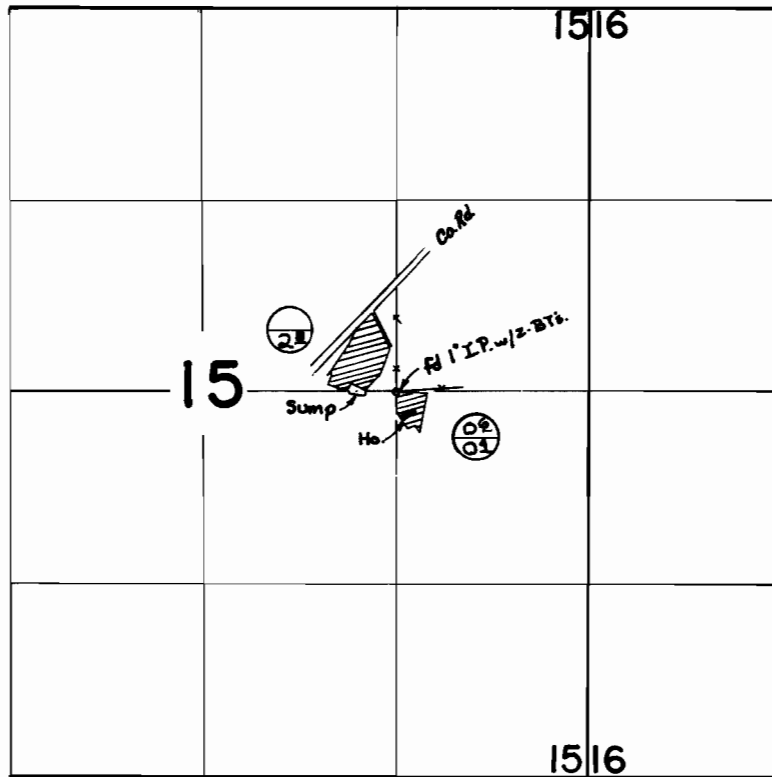

Sump Loc. 270' W fm. SE Cor. SW ¼ NE ¼, 1" IP. w/ 2 BTs.

○ Primary
○ Supplemental to Permit 25812

FINAL PROOF SURVEY UNDER

Application No. G 3283 Permit No. G 3069
IN NAME OF

ROBERT J. LANFRANCO

Surveyed 29 APRIL 1970, by D.R. BUELL