


T. 38 S. R. 7 W. W.M.

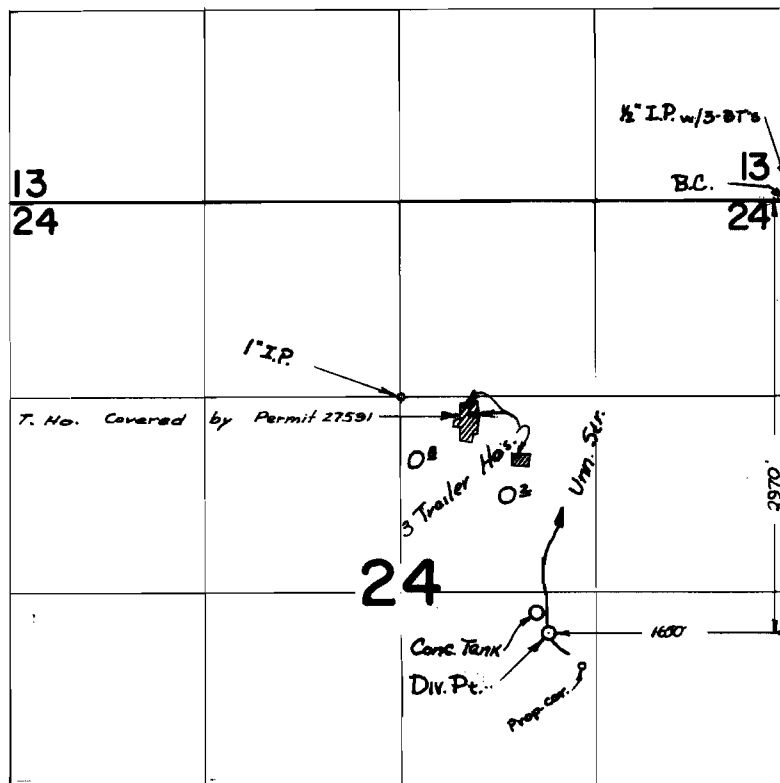

FINAL PROOF SURVEY
UNDER

Application No. 35604 Permit No. 27591
IN NAME OF

MONTE & THALIA PECK

Surveyed 28 APRIL 1970, by D. R. BUELL