


# T. 37 & 38 S. R. 5 W. W.M.

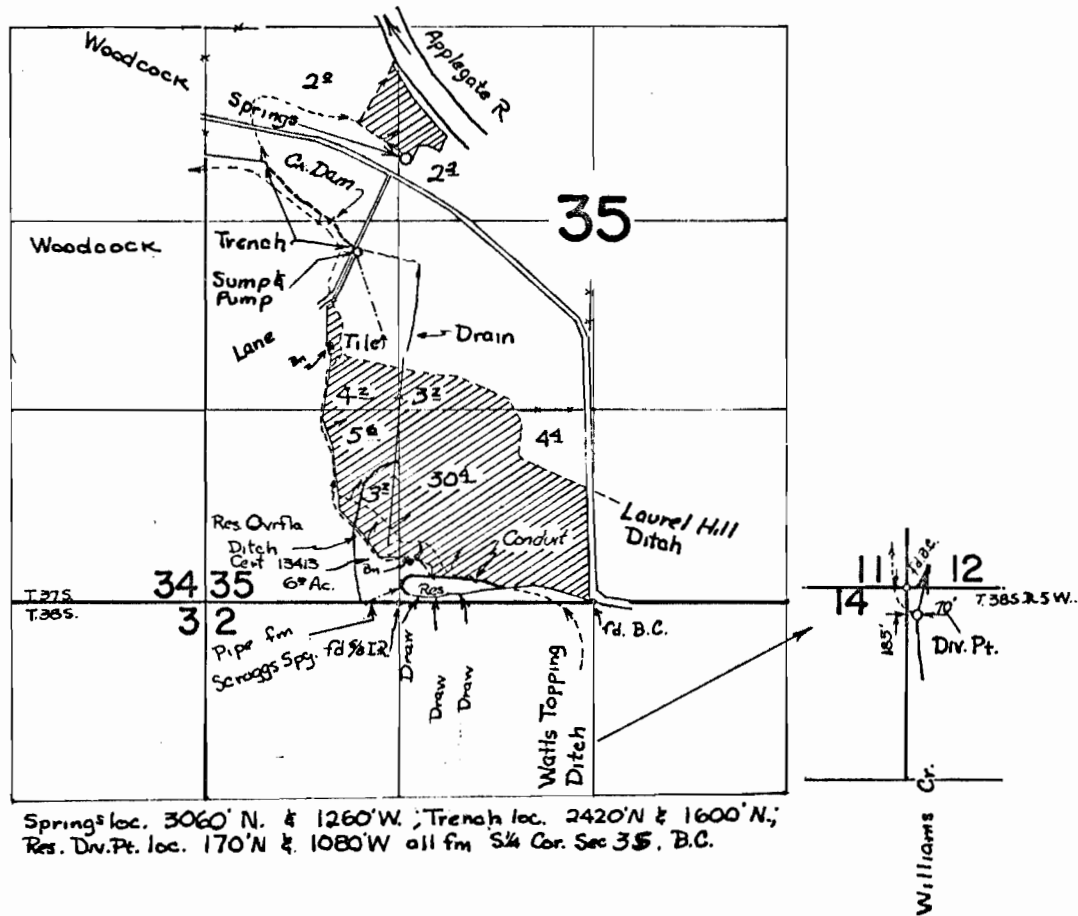

## FINAL PROOF SURVEY

UNDER

Application No. R 38699 38700 Permit No. R 3862 29162

IN NAME OF

LYLE WOODCOCK

Surveyed 14 APR 1970, by D. R. BUELL