


T. 39 S. - R. 8 W. W. M.

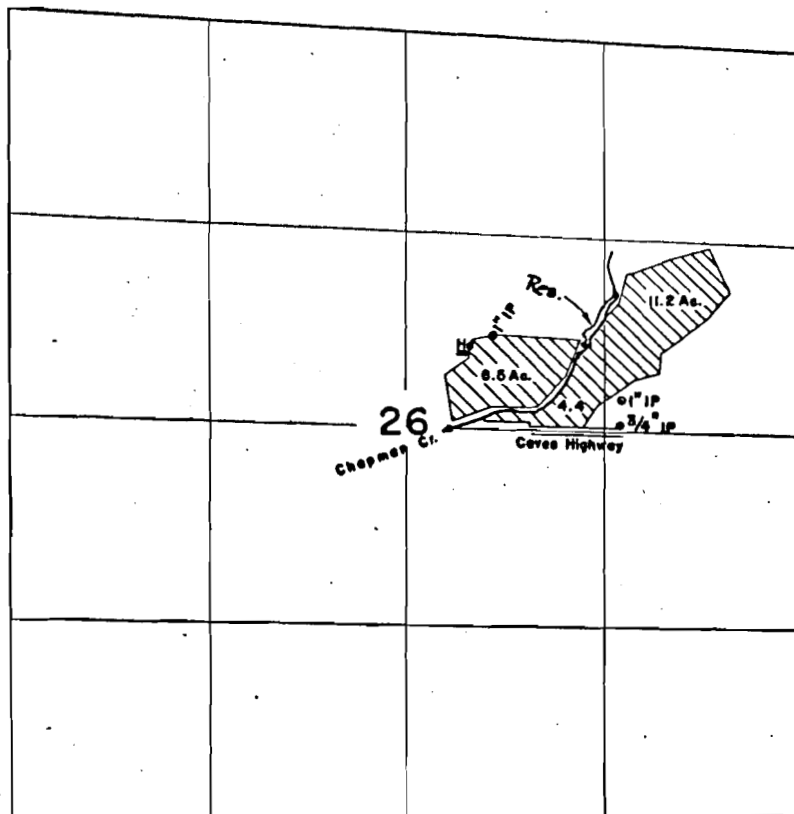

PL of Div. located 450' West and 600' North of the E. 1/4 Corner

FINAL PROOF SURVEY
UNDER

R 39104 R 3971
Application No. 39286..... TRANS. NO. W-101
Permit No. 29604.....
IN NAME OF

.....ROY M. WALDRON.....

Surveyed Feb. 18, 1965, by R.B. STEIMER.....
Apr. 28, 1970, by D.R. BUELL