


T. 39 S. R. 8 W. W.M.

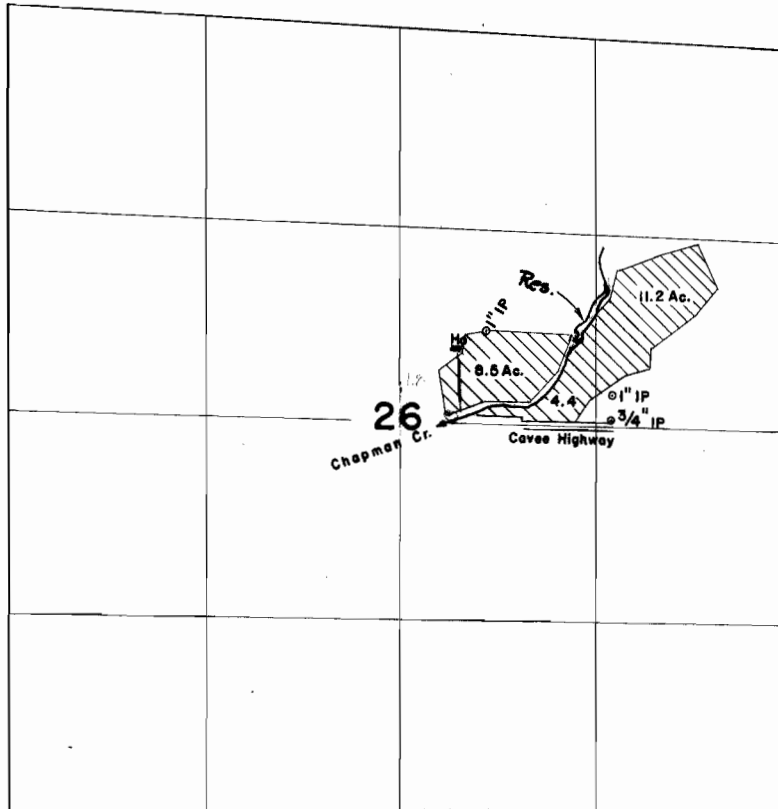

Pt. of Div. located 1400' West and 600' North of the E. 1/4 Corner

FINAL PROOF SURVEY
UNDER

R 39104 TRANS. NO. R 3971
Application No. 39286 W-101
Permit No. 29604
IN NAME OF

ROY M. WALDRON

Surveyed Feb. 18, 1965, by R.B. STEIMER
Apr. 28, 1970, by D.R. BUELL