


T. 37 S. R. 5 W. W.M.

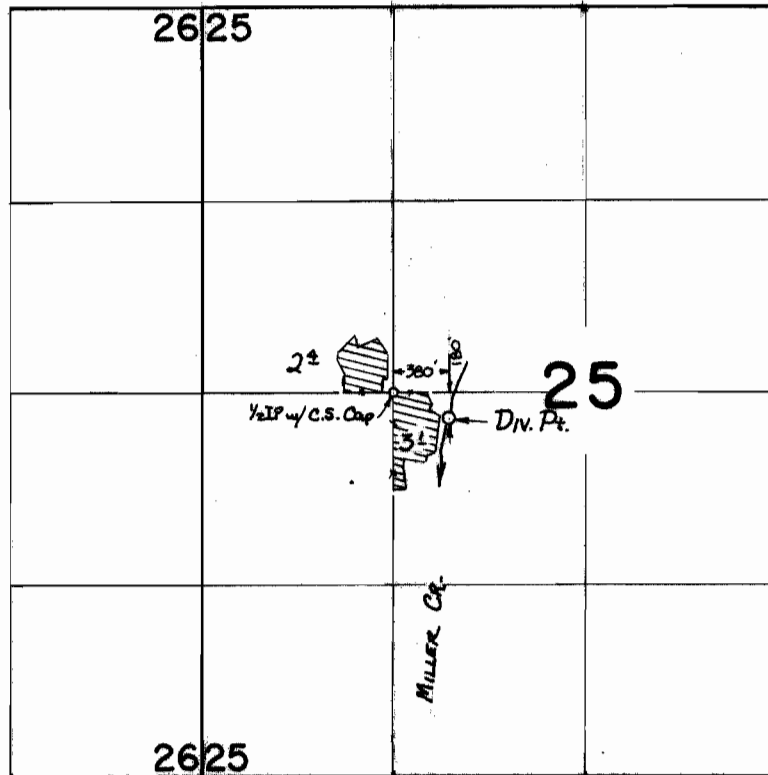

**FINAL PROOF SURVEY**  
UNDER

Application No. 43653 Permit No. 32633  
IN NAME OF

THOMAS C. SCHULTZ

Surveyed 30 APRIL 1970, by D. R. BUELL