


G-2231
377274

T. 36 S. R. 11 E. W. M.

whiskey cals, wells

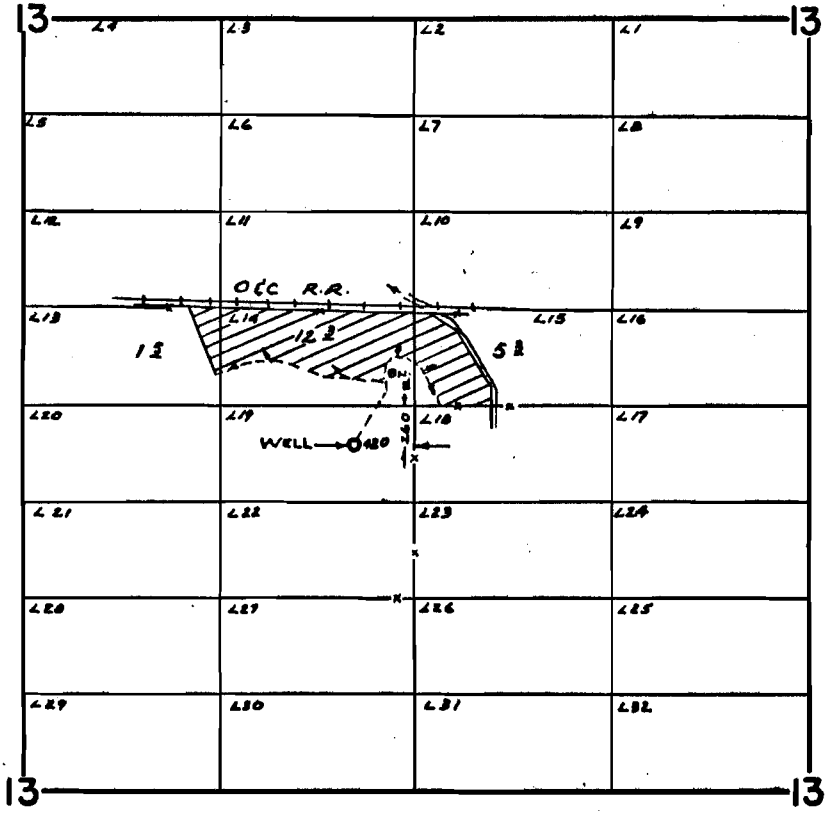

FINAL PROOF SURVEY UNDER

Application No. G-2407 Permit No. G-2231
IN NAME OF

GORDON HAROLD SMITH

Surveyed MAY 19, 1970, by R. MICKEN