

Opp. 700 1/2-340
Per. No. G-3581

Williamson River

T.30S.R.88&9E.W.M.

FINAL PROOF SURVEY


UNDER

Application No. 34534 Permit No. 27139
G-1901 G-1756

IN NAME OF

C. C. PINNEO

Surveyed Sept. 23-29-30, 1965 by *R. Peterson*

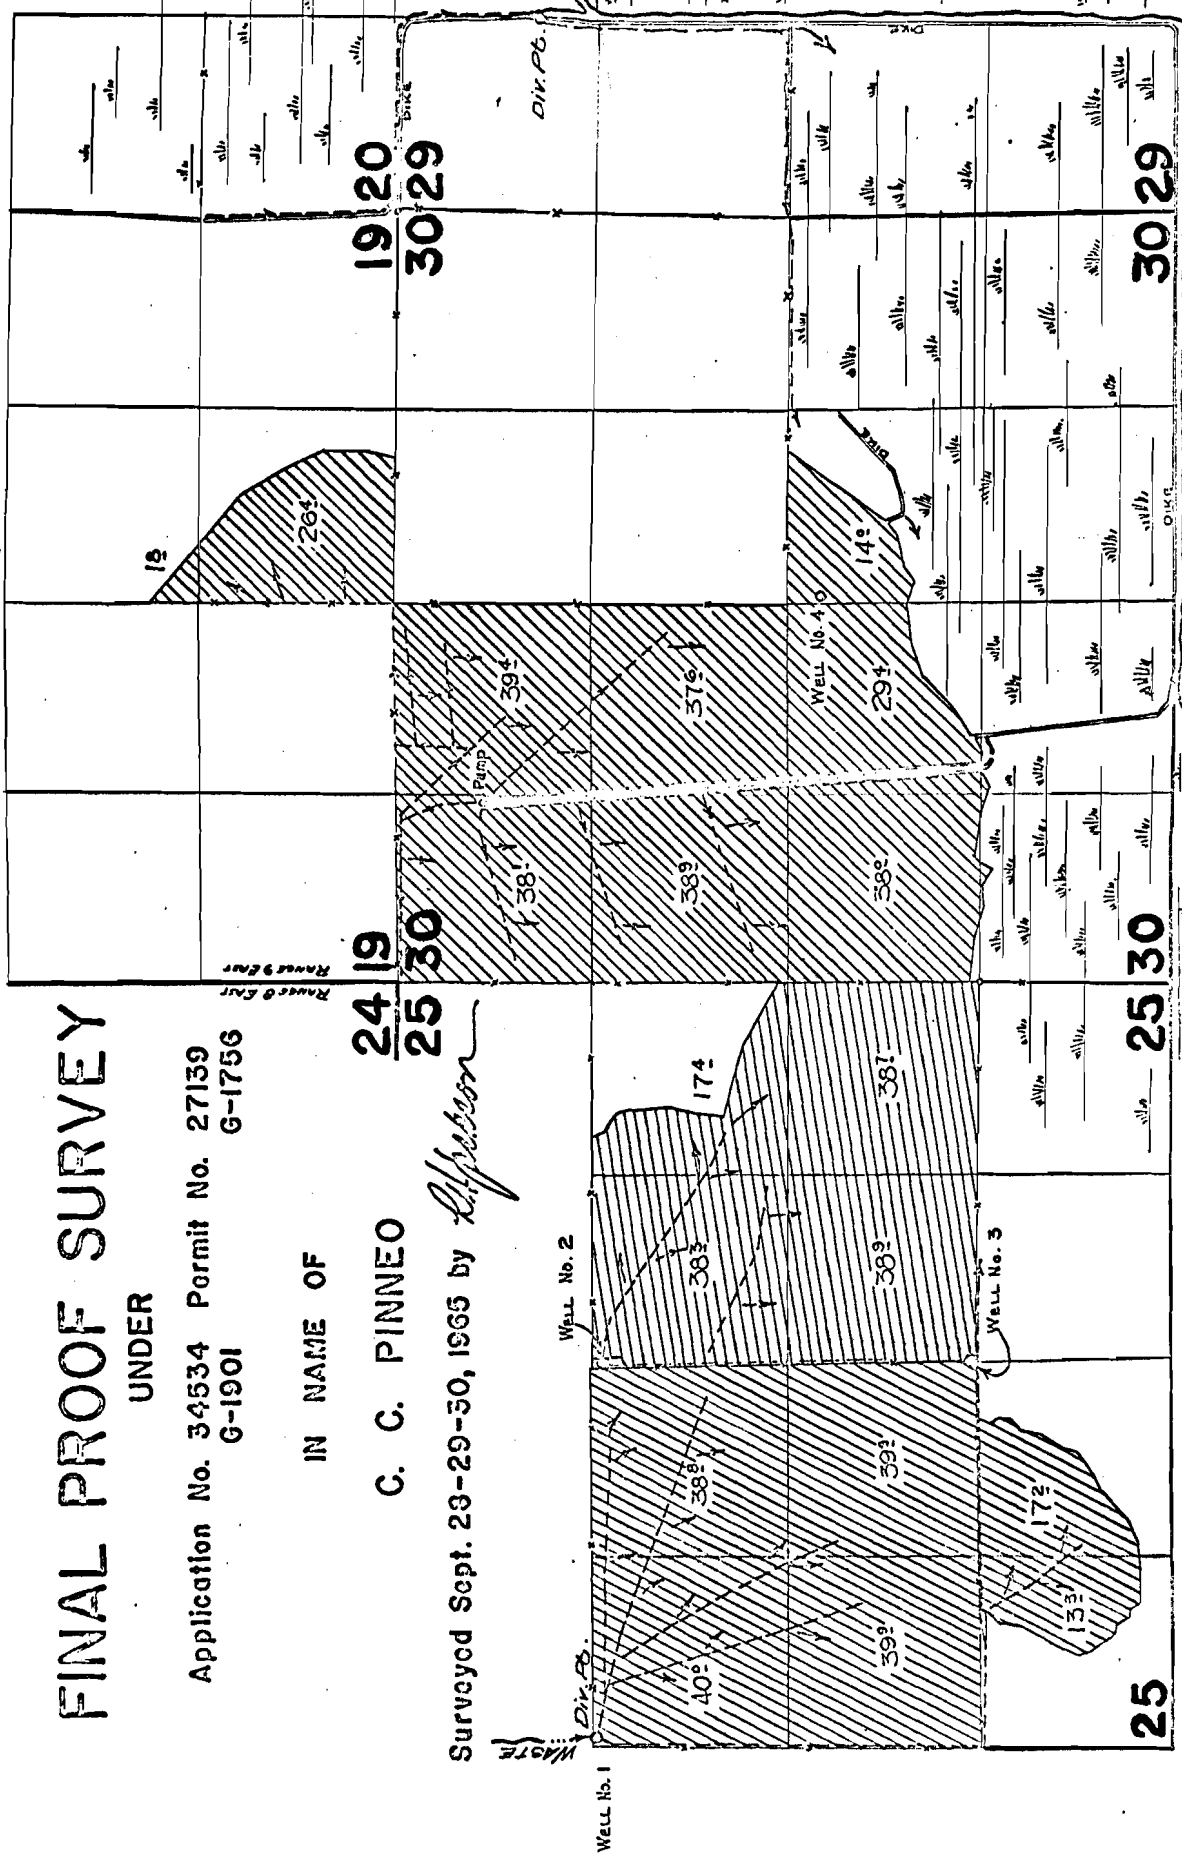

37728

KLAMATH MARSH

25

25 30

30 29

24 19
25 30

19 20
30 29

G-3581