


C37729 5

T.23S.R.6E W.M.
(UNSURVEYED)

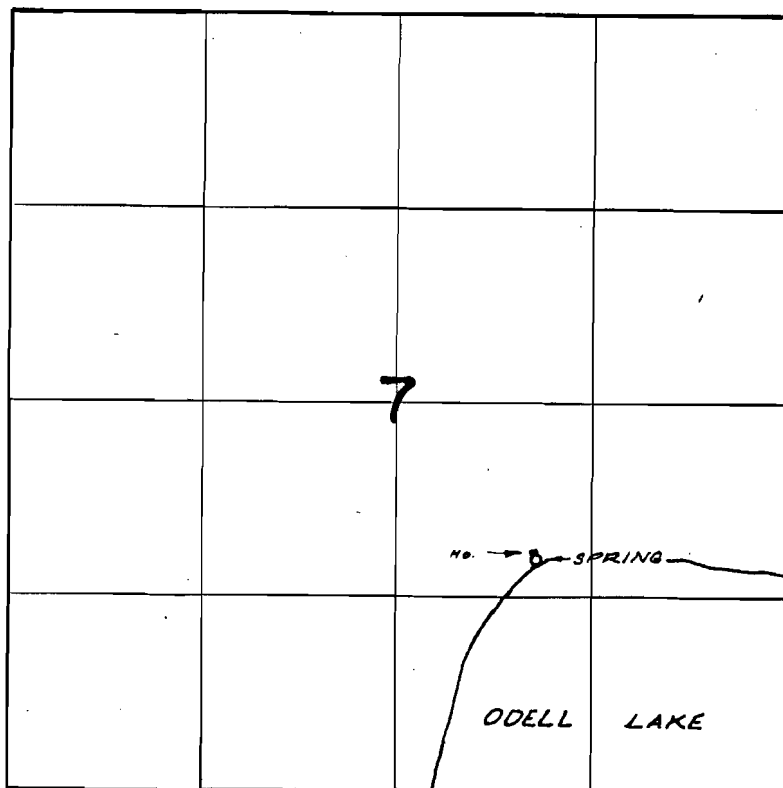

Note: Spring located from applicant's map

FINAL PROOF SURVEY
UNDER

Application No. 34263 Permit No. 26963
IN NAME OF

JAMES M. MORRIS

INSPECTED
Surveyed MAY 22, 1970, by R. MUCKEN

P 26963