


T.17S.R.4W.W.M.

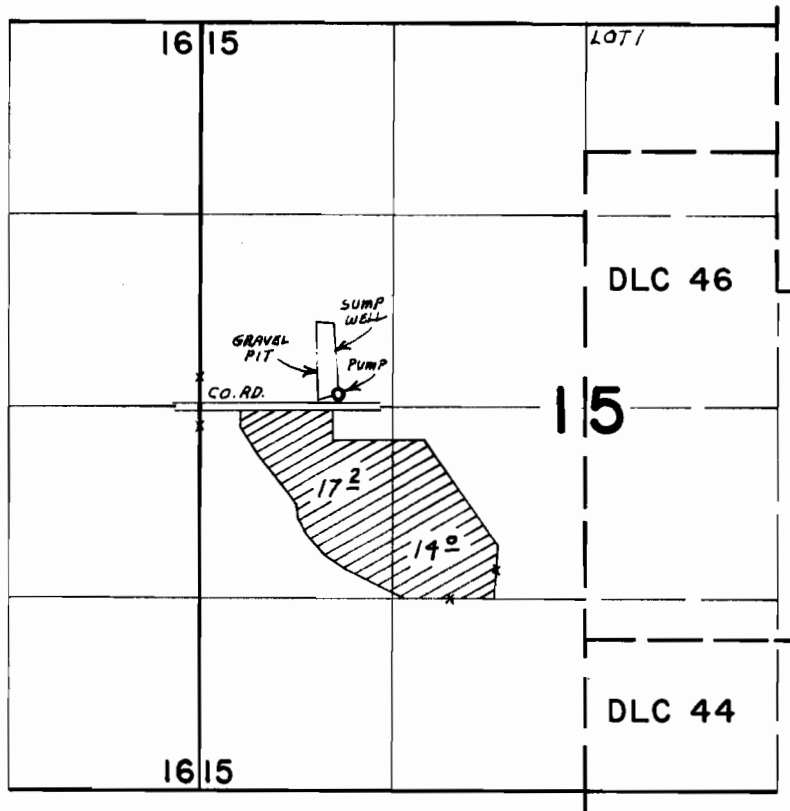

WELL LOC. 370' N. & 860' E. FROM W $\frac{1}{4}$ COR. SEC. 15

FINAL PROOF SURVEY

UNDER

ORDER OF G-3998 | COUNTY OF G-3456

E.B. BROWN III

OCT. 8 1970 | G. BACA