


T.17S.R.584W.W.M.

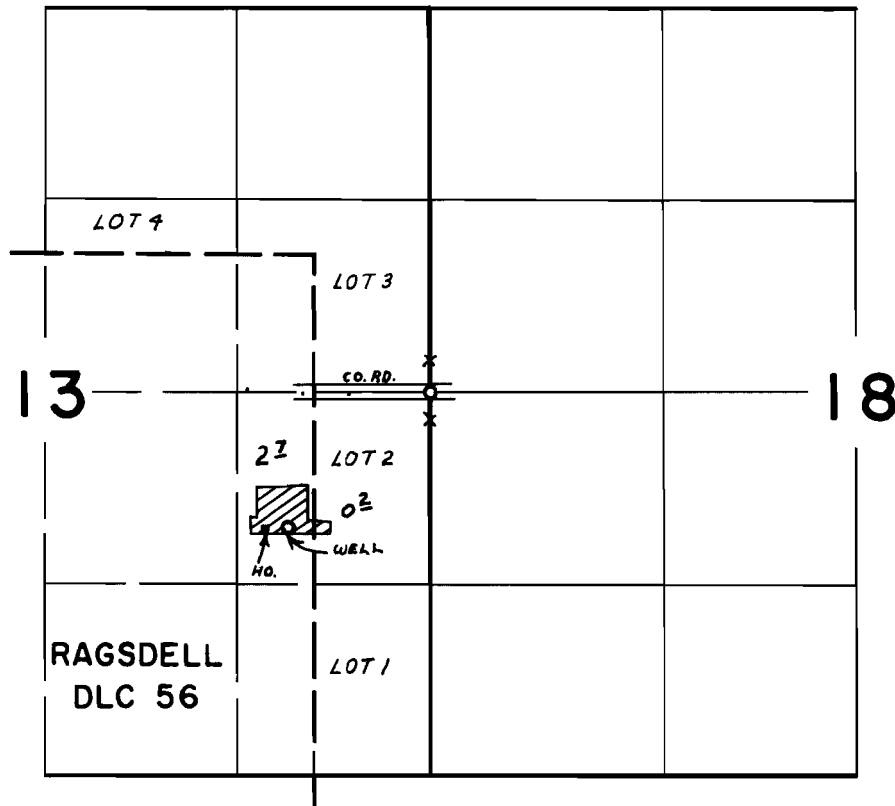

WELL LOC. 930'S. # 980'W. FROM E $\frac{1}{4}$ COR. SEC. 13

FINAL PROOF SURVEY UNDER

Application No. ~~G-4604~~ Permit No. ~~G-4328~~
IN NAME OF

PHILIP B. GRENON

Surveyed OCT. 9, 1970, by G. BACA