


T.18S.R.3&2W.W.M.

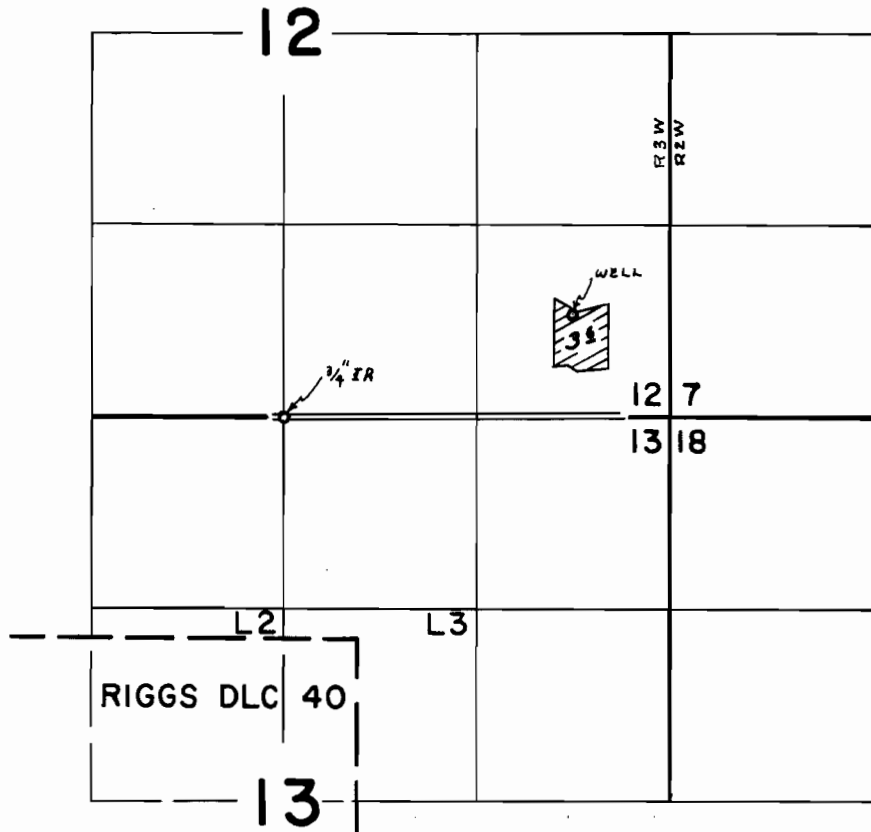

WELL LOC. 720' N. & 1970' E. FROM S $\frac{1}{4}$ COR. SEC. 12

FINAL PROOF SURVEY UNDER

Application No. G-4708 Permit No. G-4425
IN NAME OF

HAROLD ESTEP

Surveyed OCT. 12 1970, by G. BACA