


T.18S.R.5 & 4W.W.M.

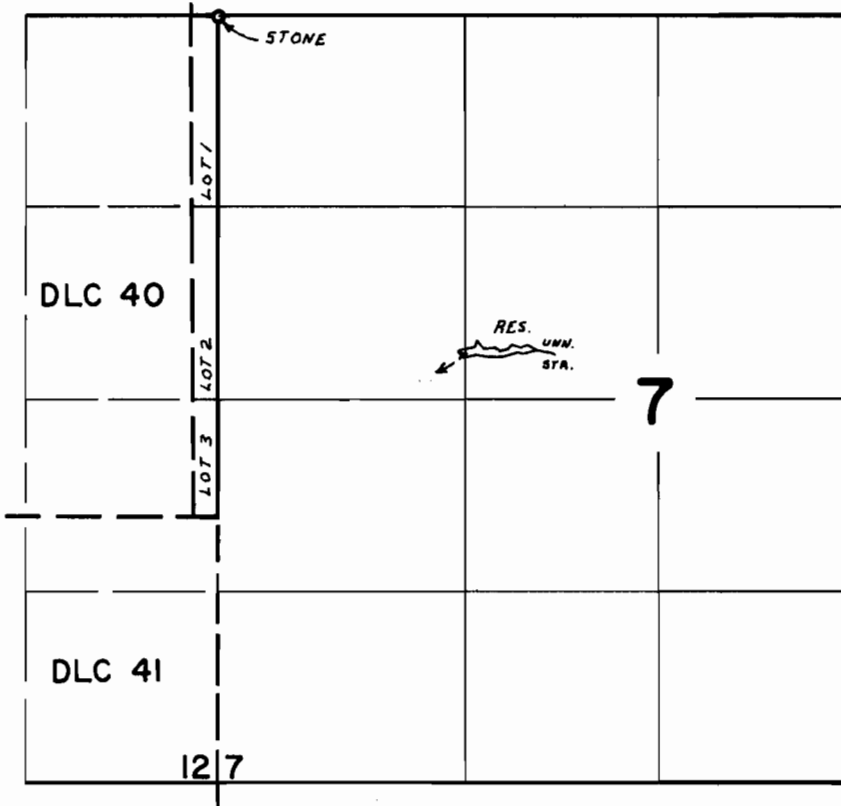

DAM LOC. 2340'S. & 1670'E. FROM NW COR. SEC. 7

FINAL PROOF SURVEY

UNDER

Application No. *R-45197* Permit No. *R-5332*

IN NAME OF

EDWARD ZINIKER

Surveyed *OCT. 13*, 19 *70*, by *G. BACA*