


T.17S.R.6W.W.M.

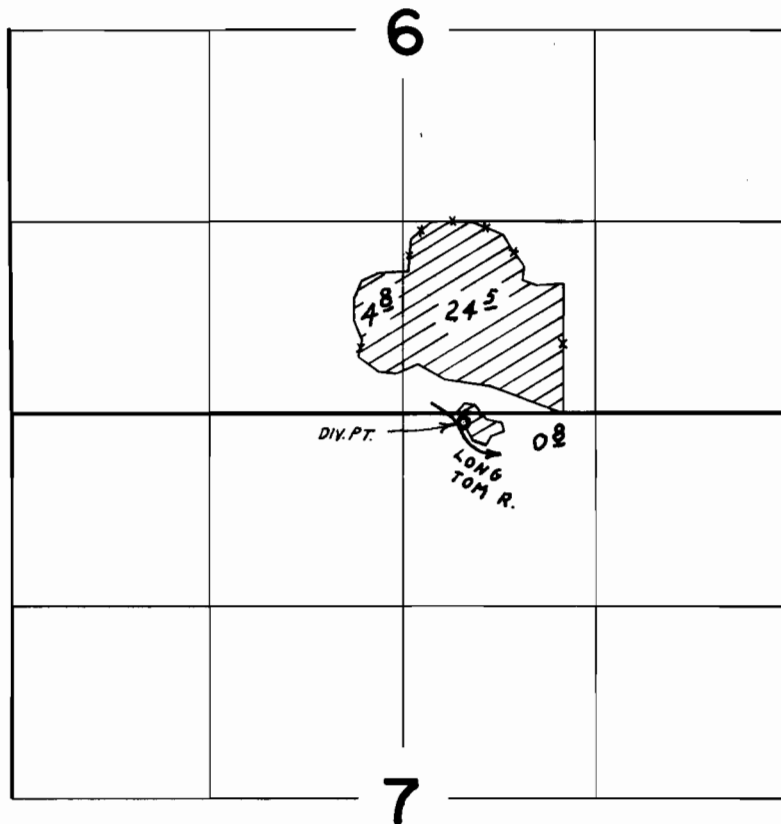

DIV. PT. LOC. 110'S. & 430'E. FROM S¹/₄ COR. SEC. 6

FINAL PROFESSIONAL SURVEY

UNDER

Application No. 39697. & Section 29542

IN FAVOR OF

HAROLD B. ASHBAUGH

Reviewed OCT. 7, 1970. by G. BACA