


T.17S.R.1W.W.M.

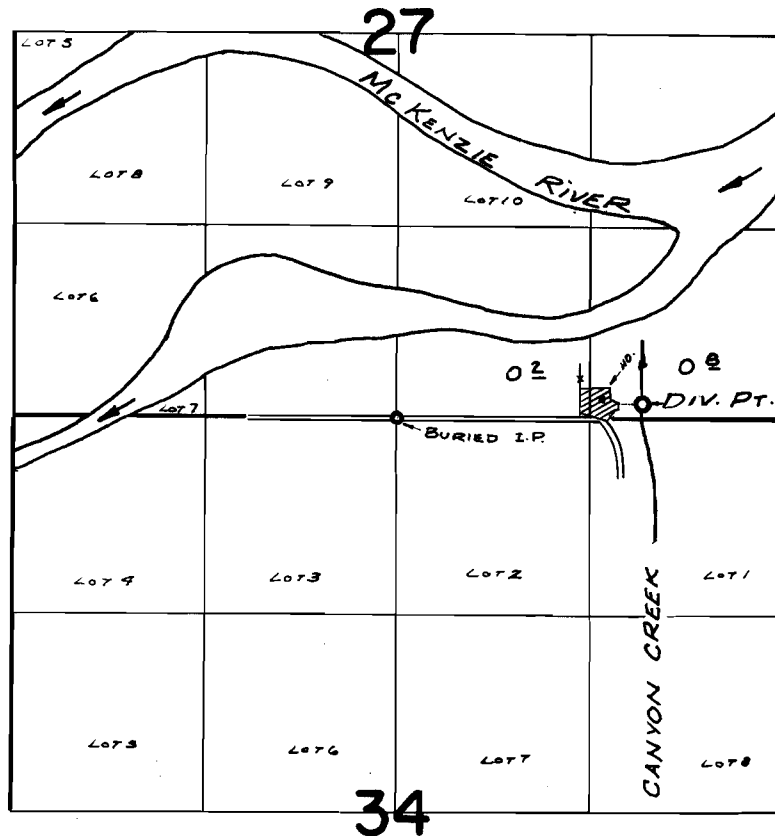

**FINAL PROOF SURVEY**  
UNDER

Application No. 40063... Permit No. 29860....  
IN NAME OF

**HOWARD K. & MARY JANE JEWETT**

Surveyed OCT. 16, 1970, by R. MUCKEN....